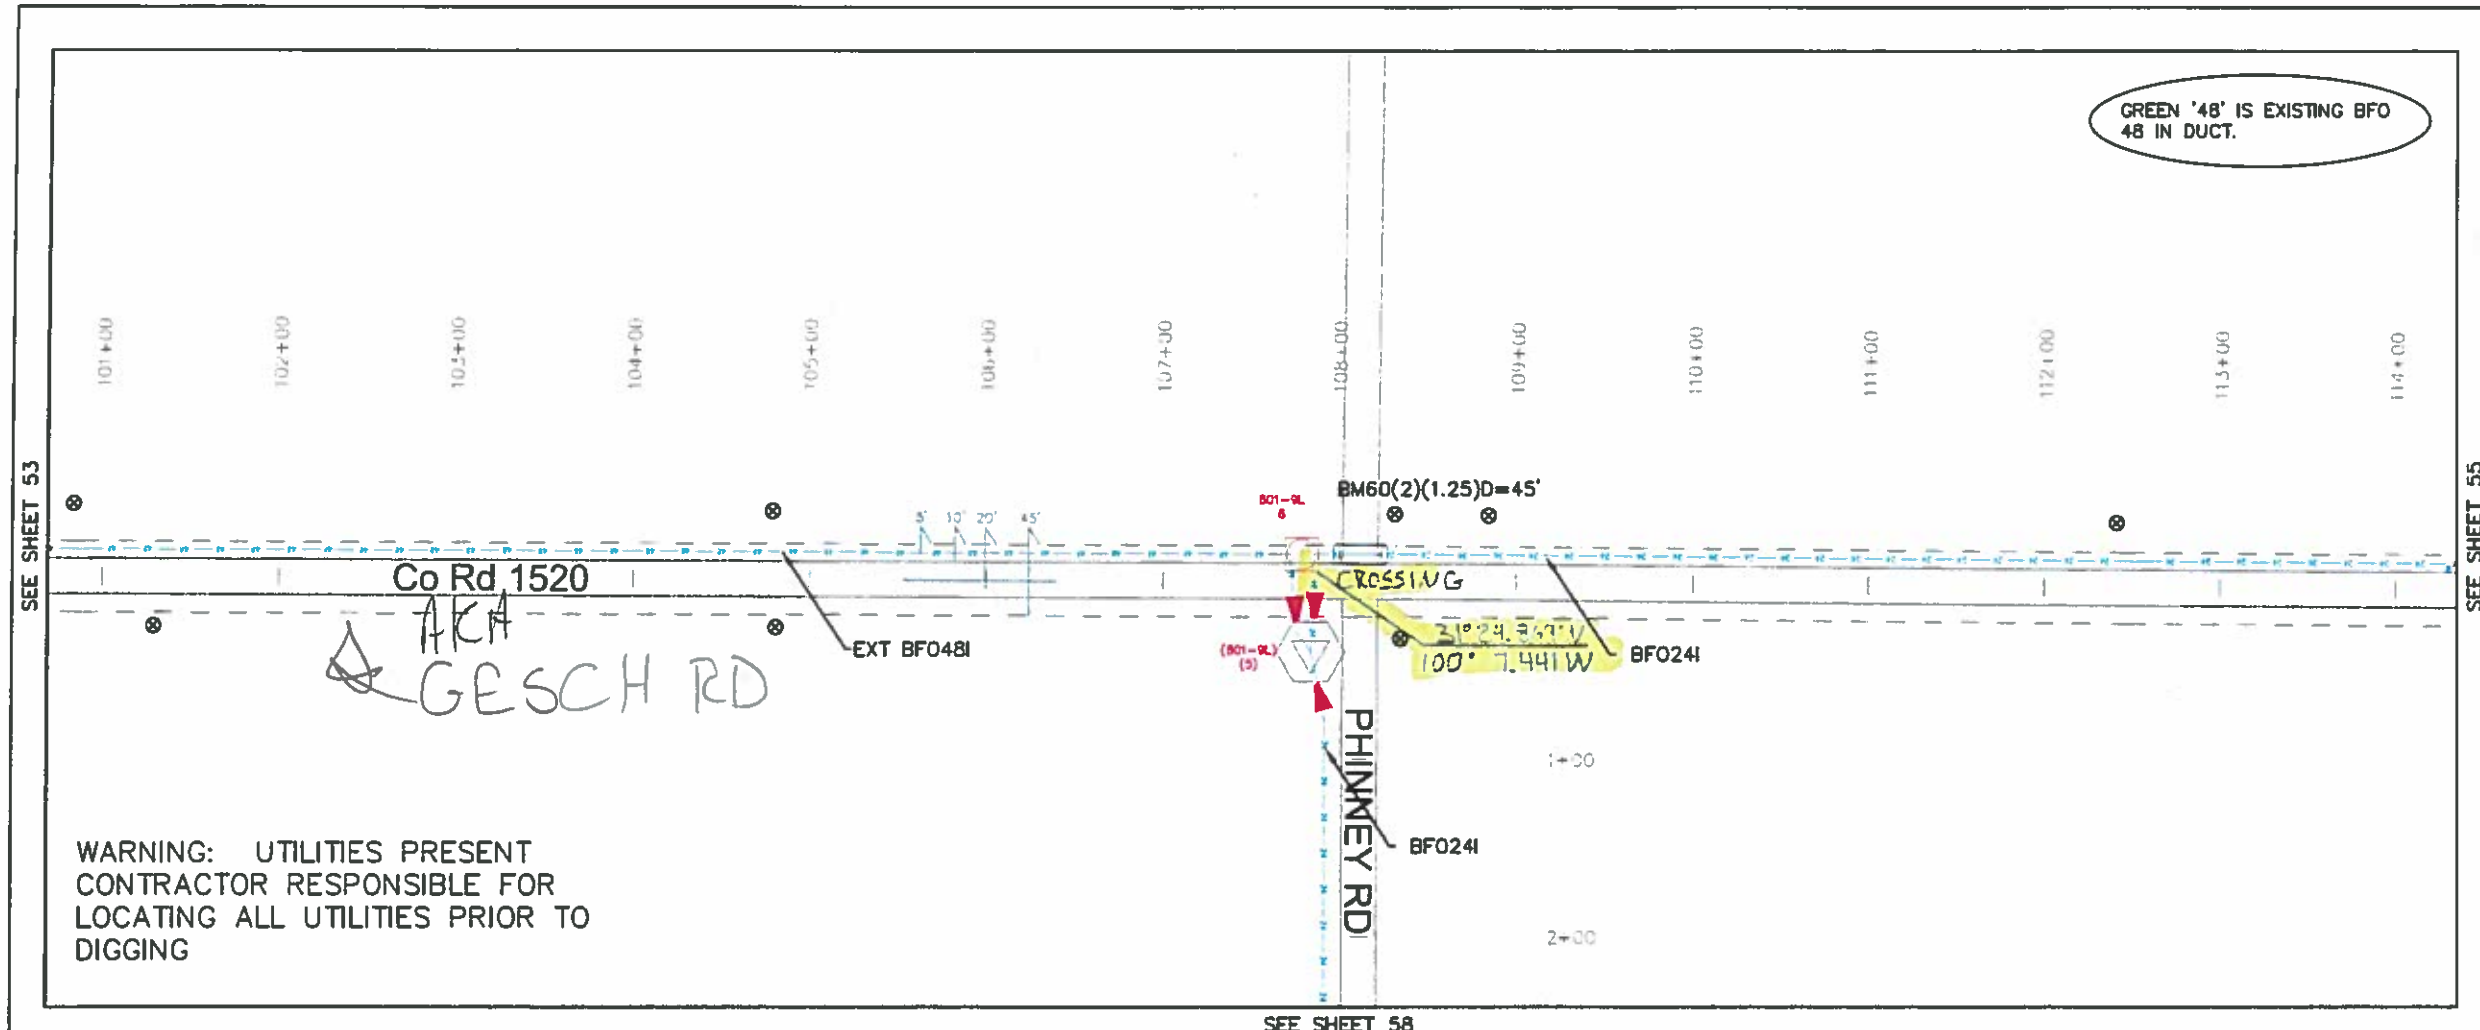

CTTC

EXCH.:	EOLA
COUNTY:	CONCHO/TOM GREEN
ROUTE:	801-9L
SHEET:	8 OF 11
PROJECT:	TX549-02
JOB NO.:	002
CONST. SHT.:	54 OF 117
MAP REF.:	TX549 EOLA 801 SS
TWP:	RGE: SEC:
TAX DIST.:	
AS BUILT DATE:	
TAX CODES	
CITY:	CO:
ESU:	FIRE:
HOSP:	SCH:
SPC:	ST:
DRAWN BY: JMA	
REVIEWED BY:	

ROUTE	HH NO		BHF (30x48 x36)T		BFO 24I	BFO 24IE						BM BHF 02	BM 53 AF	BM 52 P	BM 2E		BM 57 NS					WBHF	WBJPO (1)(1.25)		WHBFO ( )	HO 1						MISC. NOTES
801-9L	6		1		120	60							1	1			1						10									
DLC1C/801-9L	(5)				60							1		1	1							1			1	12						
					60																											
			1		240	60						1	1	2	1		1					1	10		1	12						

N-com

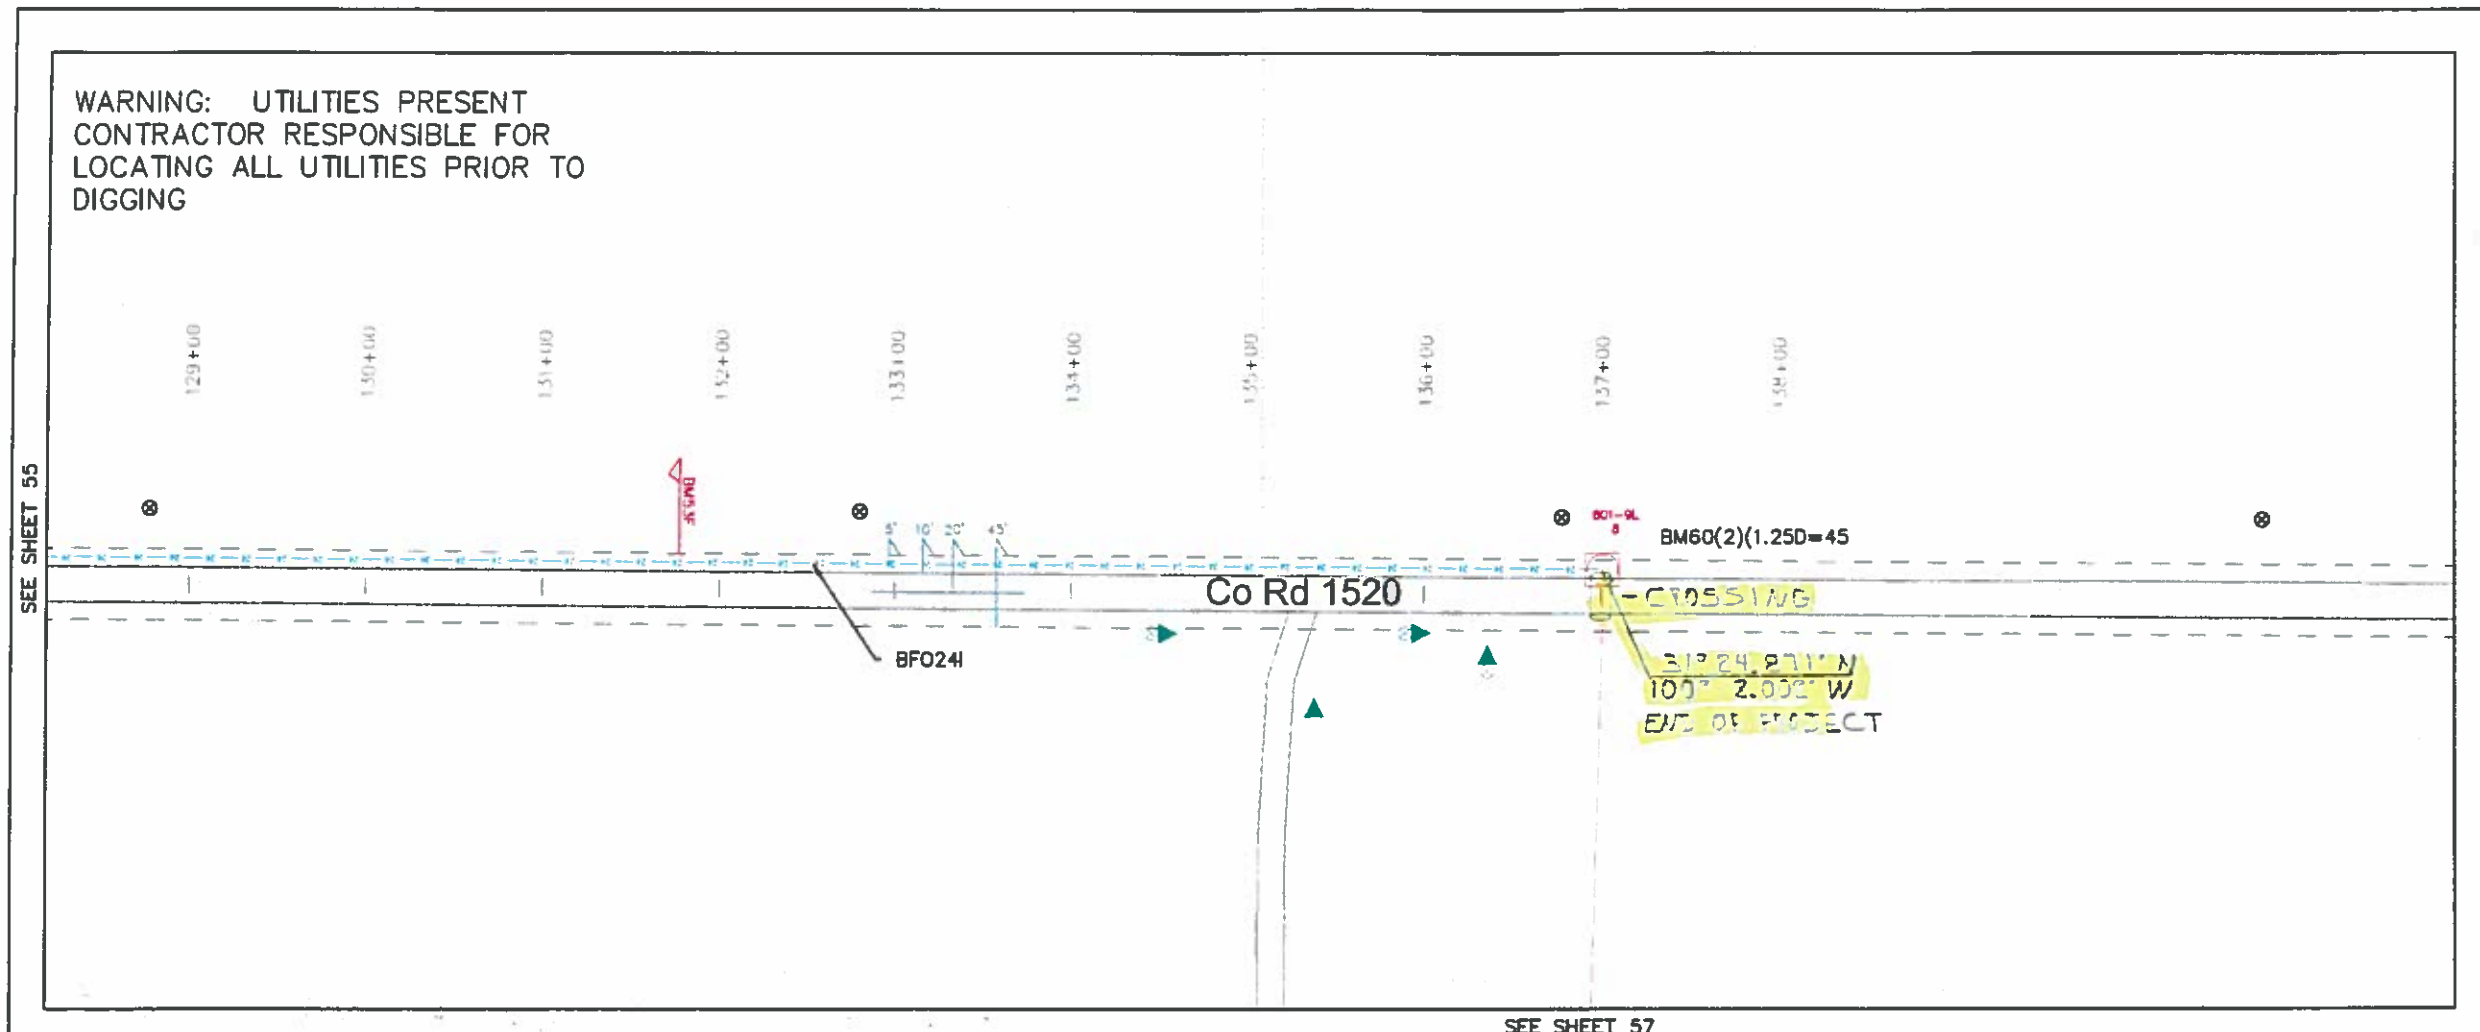

CTTC

EXCH.:	EOLA
COUNTY:	CONCHO/TOM GREEN
ROUTE:	801-9L
SHEET:	10 OF 11
PROJECT:	TX549-02
JOB NO.:	002
CONST. SHT.:	56 OF 117
MAP REF.:	TX549 EOLA 801 SS
TWP:	RGE: SEC:
TAX DIST.:	
AS BUILT DATE:	
TAX CODES	
CITY:	CO:
ESU:	FIRE:
HOSP:	SCH:
SPC:	ST:
DRAWN BY: JMA	
REVIEWED BY:	

ROUTE	HH NO		BHF (30x48 x36)T		BFO 241						BMPD (2)(1.25)	BM BHF 02	BM 53 AF	BM 52 P	BM 55 B	BM 57 F	BM 53 F	BM 83			BM60 (2) (1.25)D			HBFO (4)		HO 1			NID 3G	SEBPD (1) (1.25)	SEB FO 41	MISC. NOTES
801-9L	8		1		1286						1286	1	1	1	1	1	1	1			45			1		2			1	361	60	
					120																										406	
																															10	
			1		1406						1286	1	1	1	1	1	1	1			45			1		2			1	361	476	

N-com