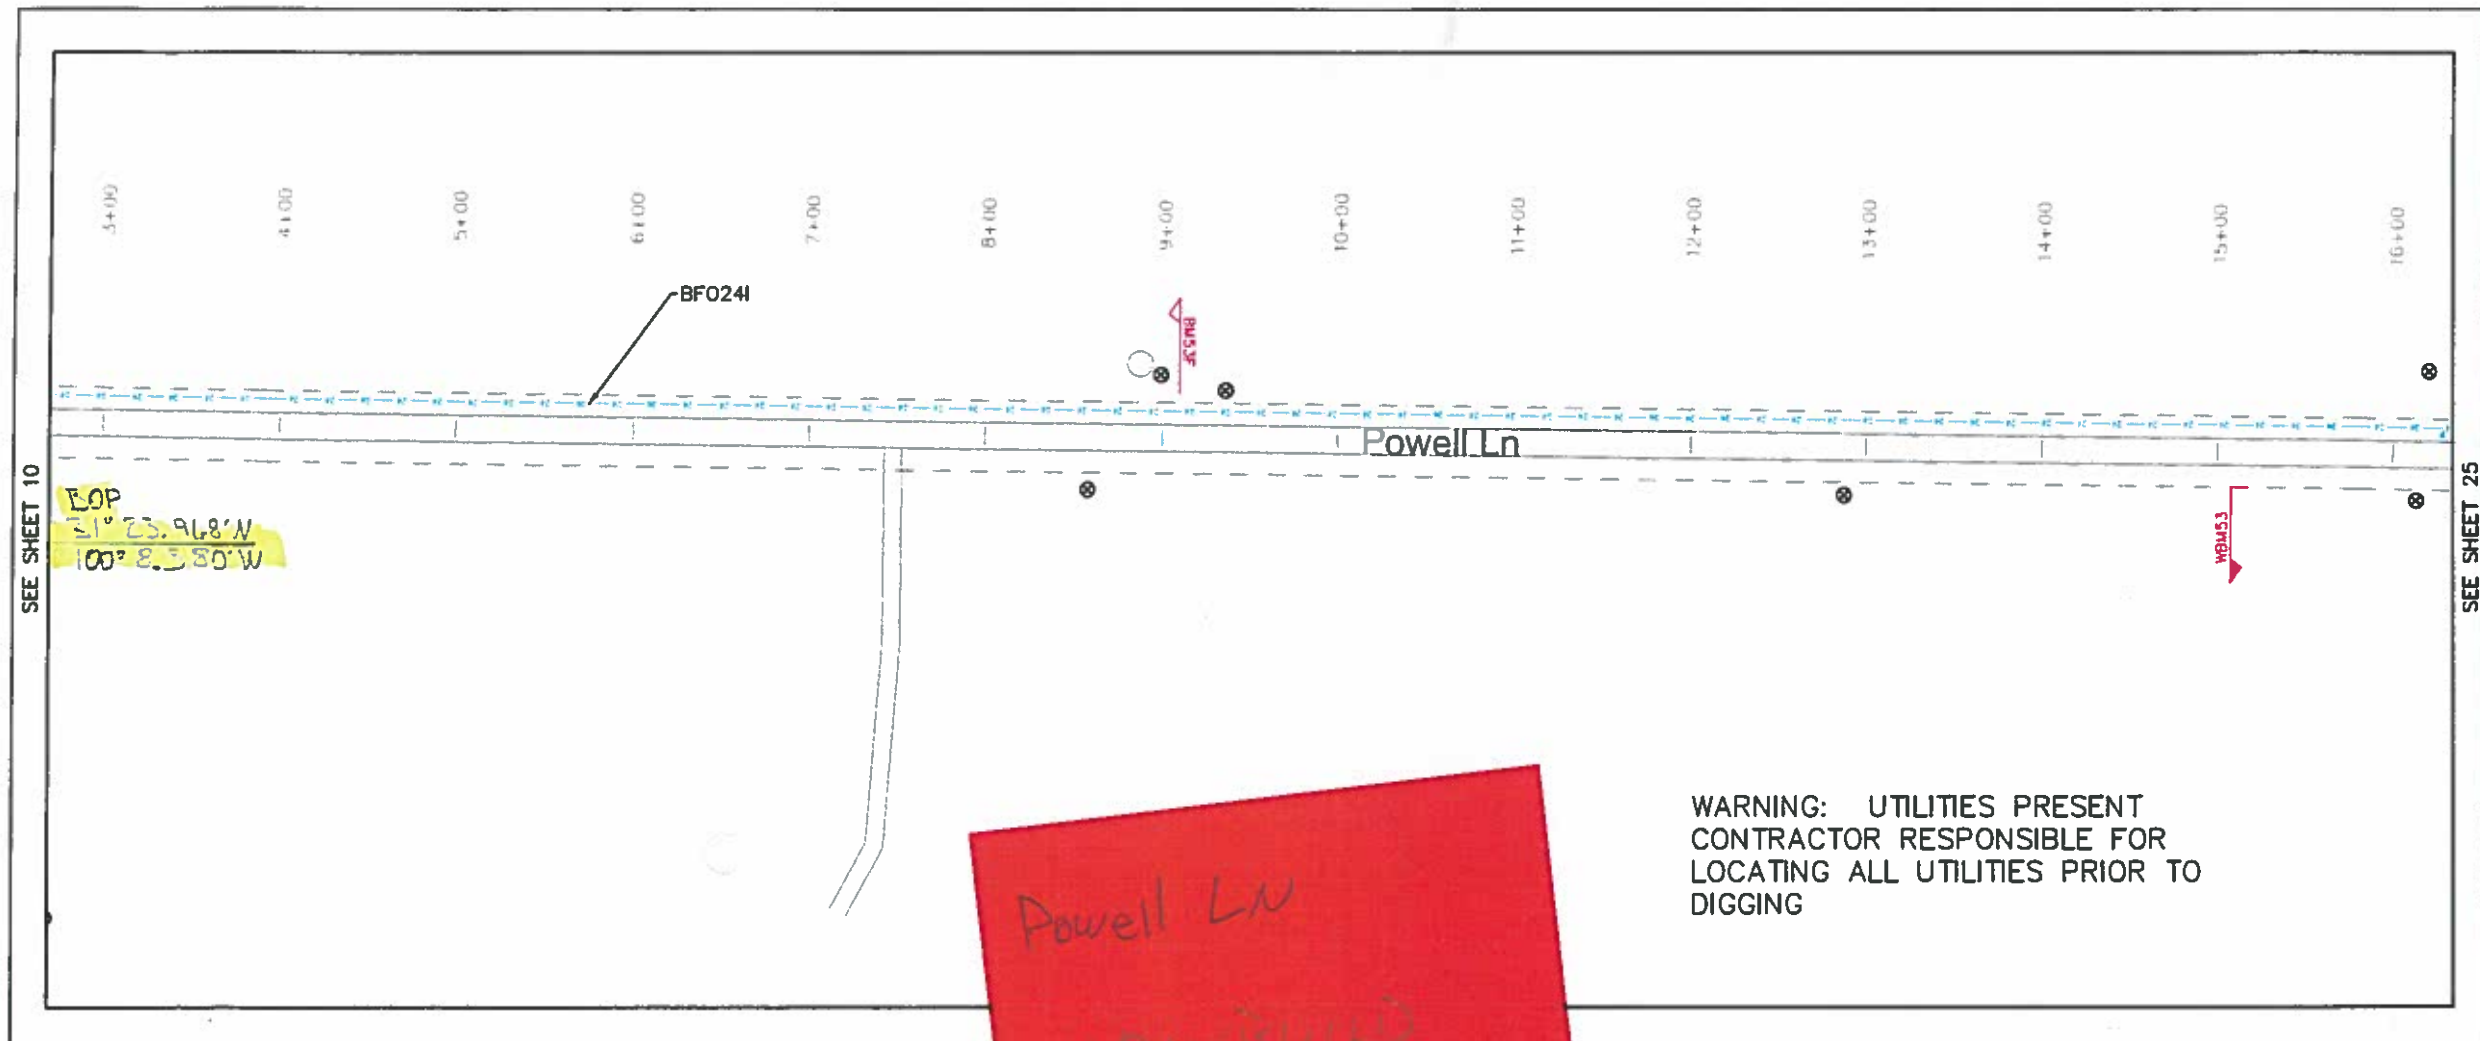

CTTC

EXCH.:	EOLA
COUNTY:	CONCHO/TOM GREEN
ROUTE:	804-8
SHEET:	1 OF 2
PROJECT:	TX549-02
JOB NO.:	002
CONST. SHT.:	24 OF 33
MAP REF.:	TX549 EOLA 804 SS
TWP:	RGE: SEC:
TAX DIST.:	
AS BUILT DATE:	
TAX CODES	
CITY:	CO:
ESU:	FIRE:
HOSP:	SCH:
SPC:	ST:
DRAWN BY: JMA	
REVIEWED BY:	

ROUTE	HH NO
804	

MISC. NOTES

N-com

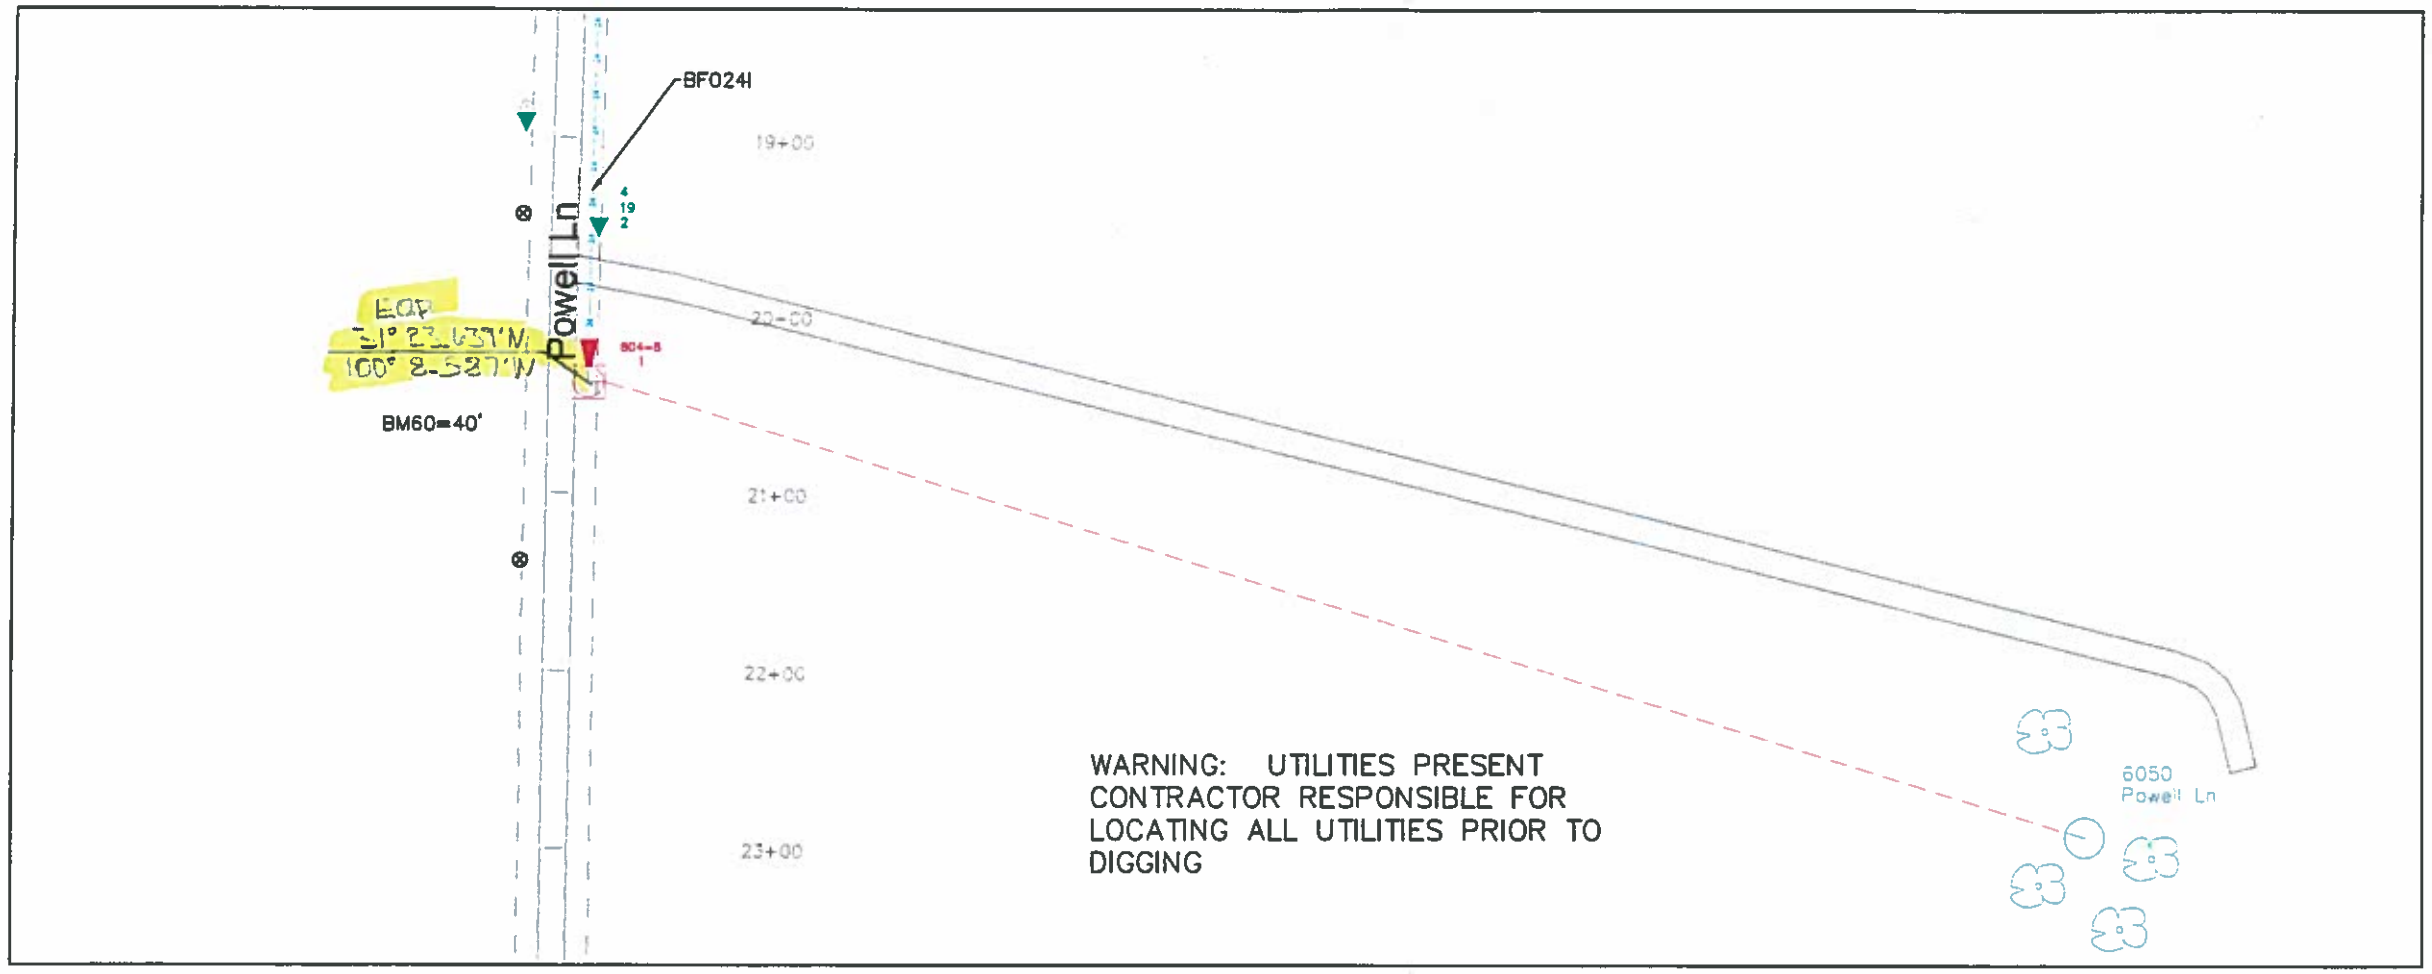

CTTC

EXCH.:	EOLA
COUNTY:	CONCHO/TOM GREEN
ROUTE:	804-8
SHEET:	2 OF 2
PROJECT:	TX549-02
JOB NO.:	002
CONST. SHT.:	25 OF 33
MAP REF.:	TX549 EOLA 804 SS
TWP:	RGE: SEC:
TAX DIST.:	
AS BUILT DATE:	
TAX CODES	
CITY:	CO:
ESU:	FIRE:
HOSP:	SCH:
SPC:	ST:
DRAWN BY: JMA	
REVIEWED BY:	

ROUTE	HH NO	BHF (24x36 x30)T			BFO 24I						BMPO (2)(1.25)	BM 53 F	BM 53 AF	BM 52 P	BM 55 B	BM 57 F	WBM 53	BM 63	BM BHF 02	BM60 (2)(1.25) D				HBFO (S)		HO 1	BM AGW	SEBPO (1.25)	NID 4G		SEB FO 4I	MISC. NOTES
	8-1	1			1962						1922	1	1	1	1	1	1	1	1	40				1		2	70	930	1		930	
					60																											60
																																10
		1			2022						1922	1	1	1	1	1	1	1	1	40				1		2	70	930	1		1000	

N-com