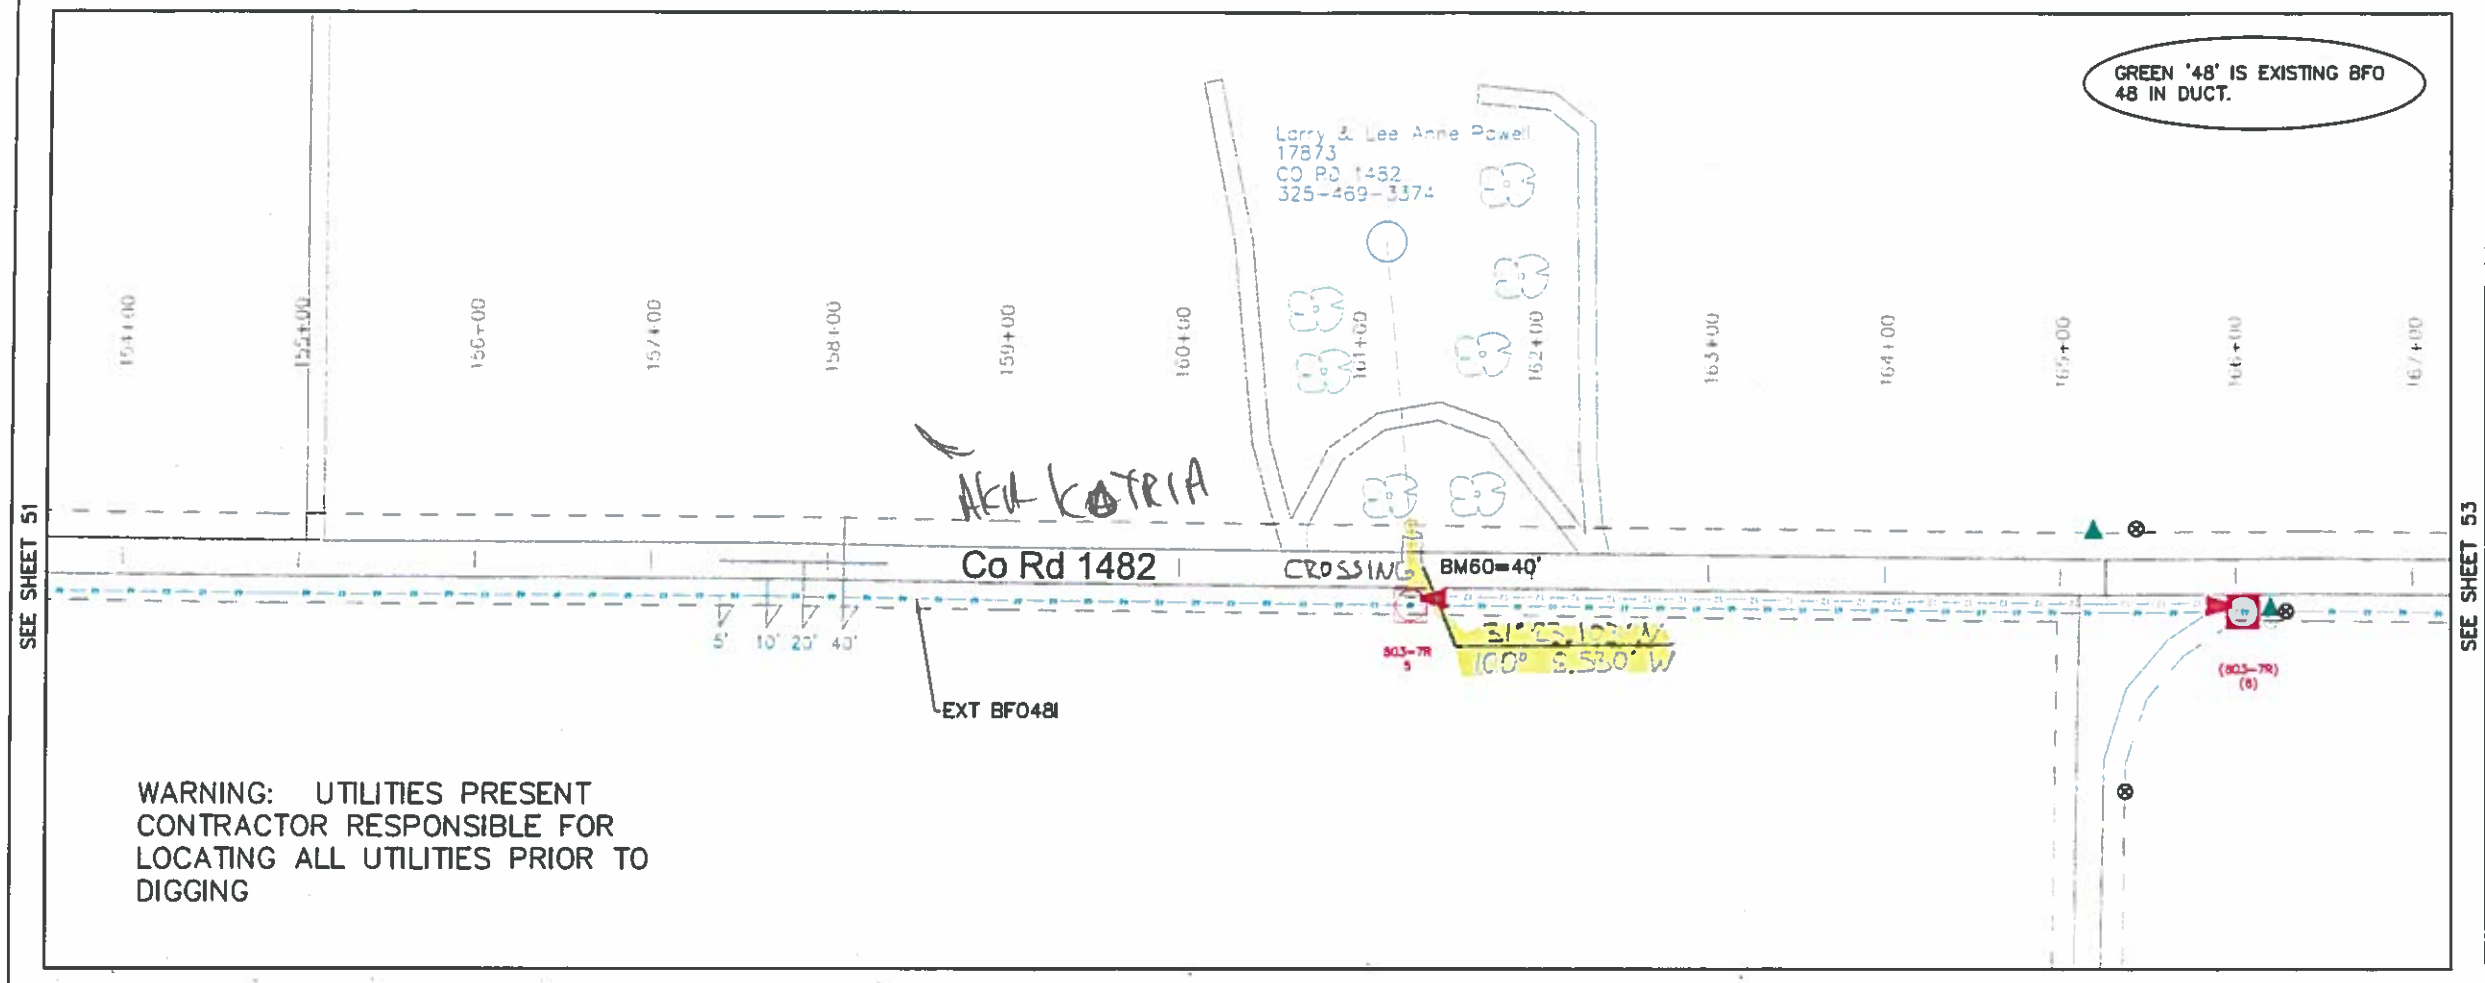

CTTC

EXCH.:	EOLA
COUNTY:	CONCHO/TOM GREEN
ROUTE:	803/7R
SHEET:	11 OF 13
PROJECT:	TX549-02
JOB NO.:	002
CONST. SHT.:	52 OF 63
MAP REF.:	TX549 EOLA 803 SS
TWP:	RGE: SEC:
TAX DIST.:	
AS BUILT DATE:	
TAX CODES	
CITY:	CO:
ESU:	FIRE:
HOSP:	SCH:
SPC:	ST:
DRAWN BY:	JMA
REVIEWED BY:	

ROUTE	HH NO	WBHF	BHF (24x36 x30)T		BFO 24I	BFO 24IE						WBM 52 P	BM 53 AF	BM 52 P	BM 55 B	BM 57 F	BM 57 FR	BM 83	BM BHF 02	BM60 (2)(1.25) D			WBMPD (1)(1.25)	HBFO (M)		HO 1	NID 3G	SEBPD (1.25)			SEB FO 4I	MISC. NOTES
803-7R	5		1		60								1	1	1	1		1	1	40			10	1		2	1	120			160	
																															60	
																															10	
803-7R	(6)	1			60	520						1			1		1							1		1						
		1	1		120	520						1	1	1	2	1	1	1	1	40			10	2		3	1	120			230	

N-com

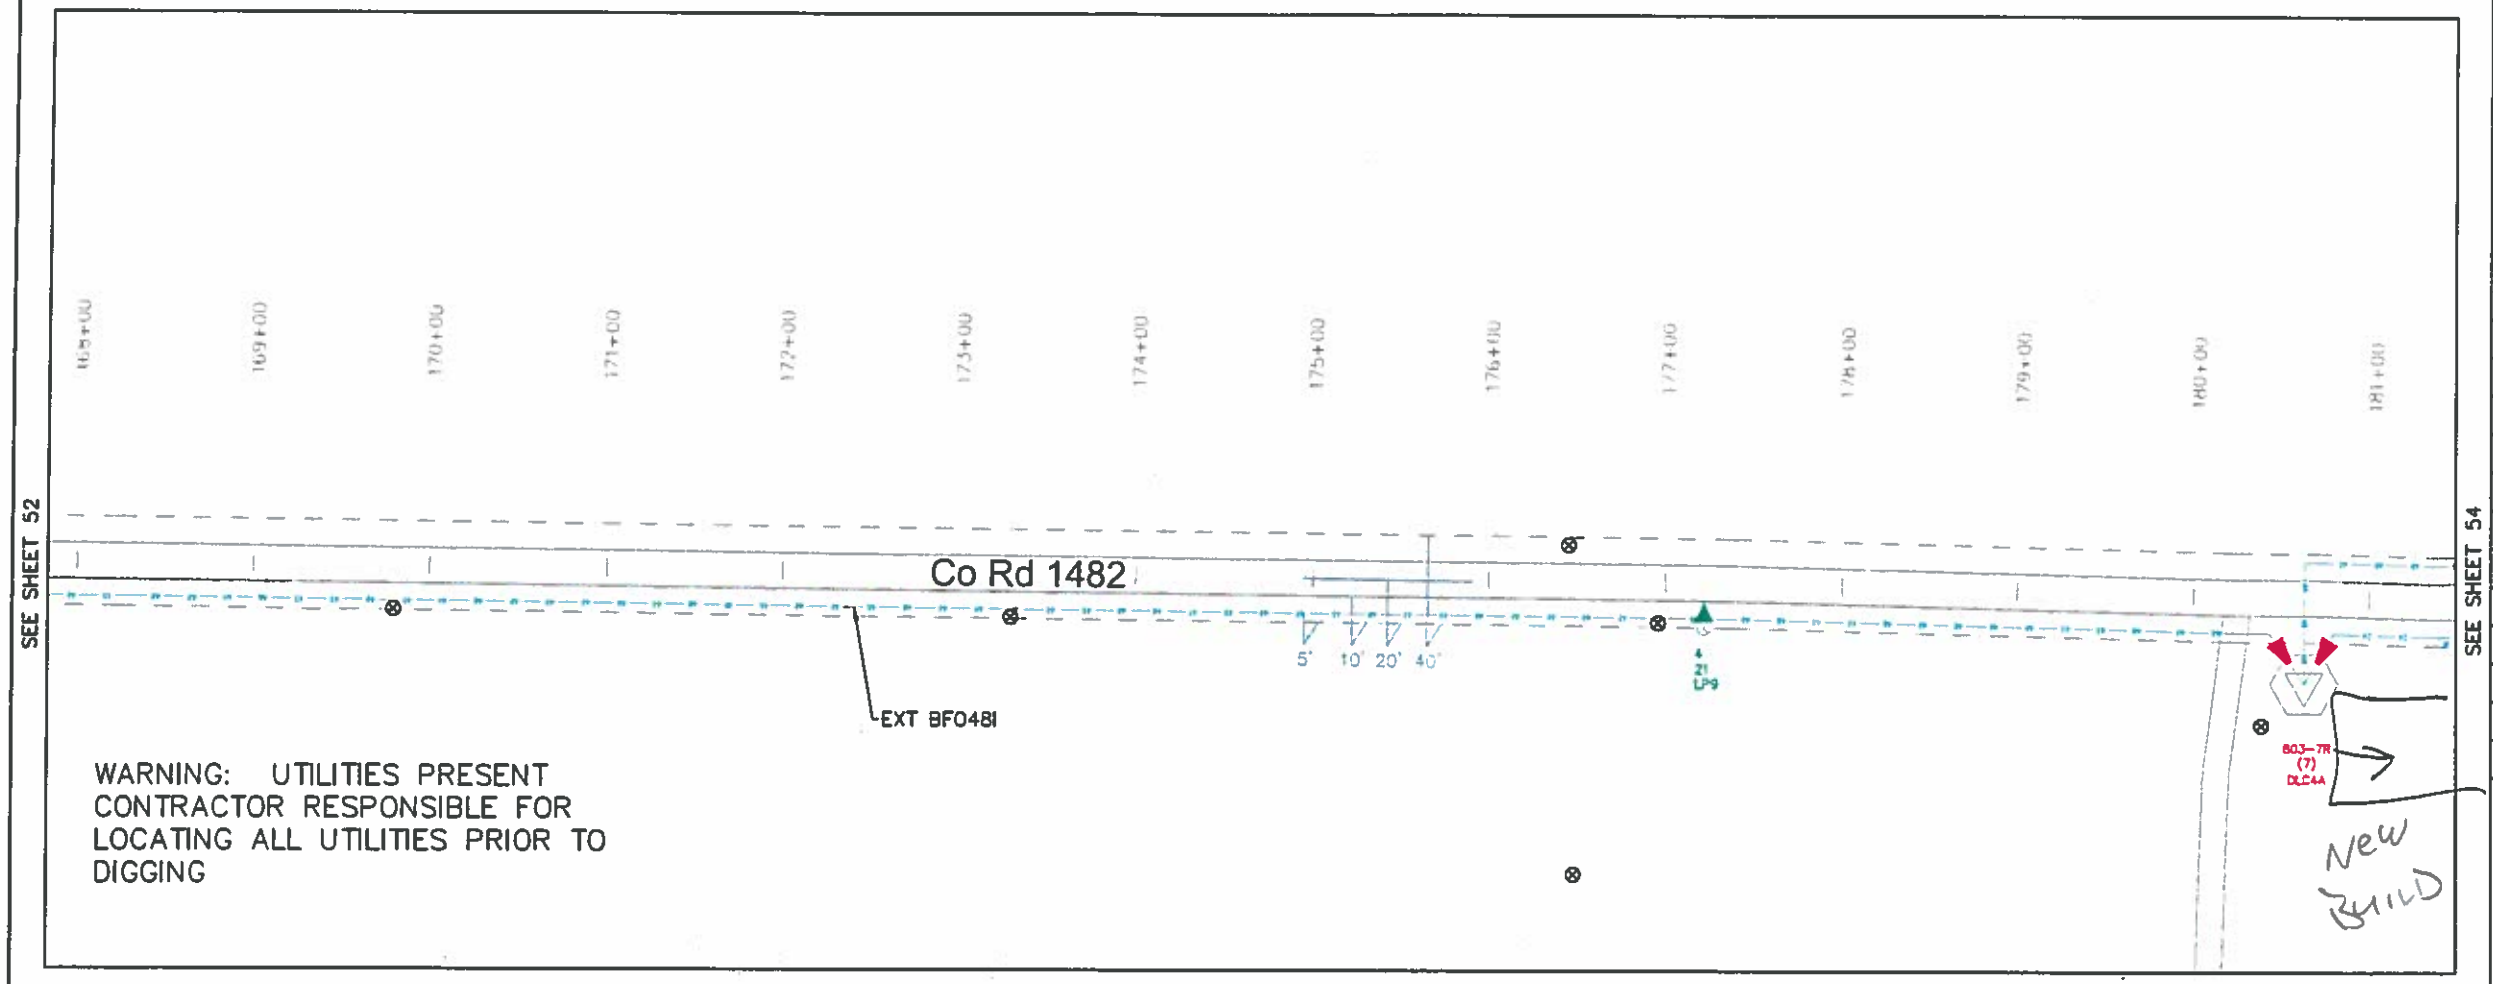

CTTC

EXCH.:	EOLA
COUNTY:	CONCHO/TOM GREEN
ROUTE:	803/7R
SHEET:	12 OF 13
PROJECT:	TX549-02
JOB NO.:	002
CONST. SHT.:	53 OF 63
MAP REF.:	TX549 EOLA 803 SS
TWP:	RGE: SEC:
TAX DIST.:	
AS BUILT DATE:	
TAX CODES	
CITY:	CO:
ESU:	FIRE:
HOSP:	SCH:
SPC:	ST:
DRAWN BY:	JMA
REVIEWED BY:	

ROUTE	HH NO	WBHF	BM 2E		BFO 24I																			WHBFO		HO 1					
803-7R	(7)	1	1		60																			1		1					
		1	1		60																			1		1					

MISC. NOTES

N-com

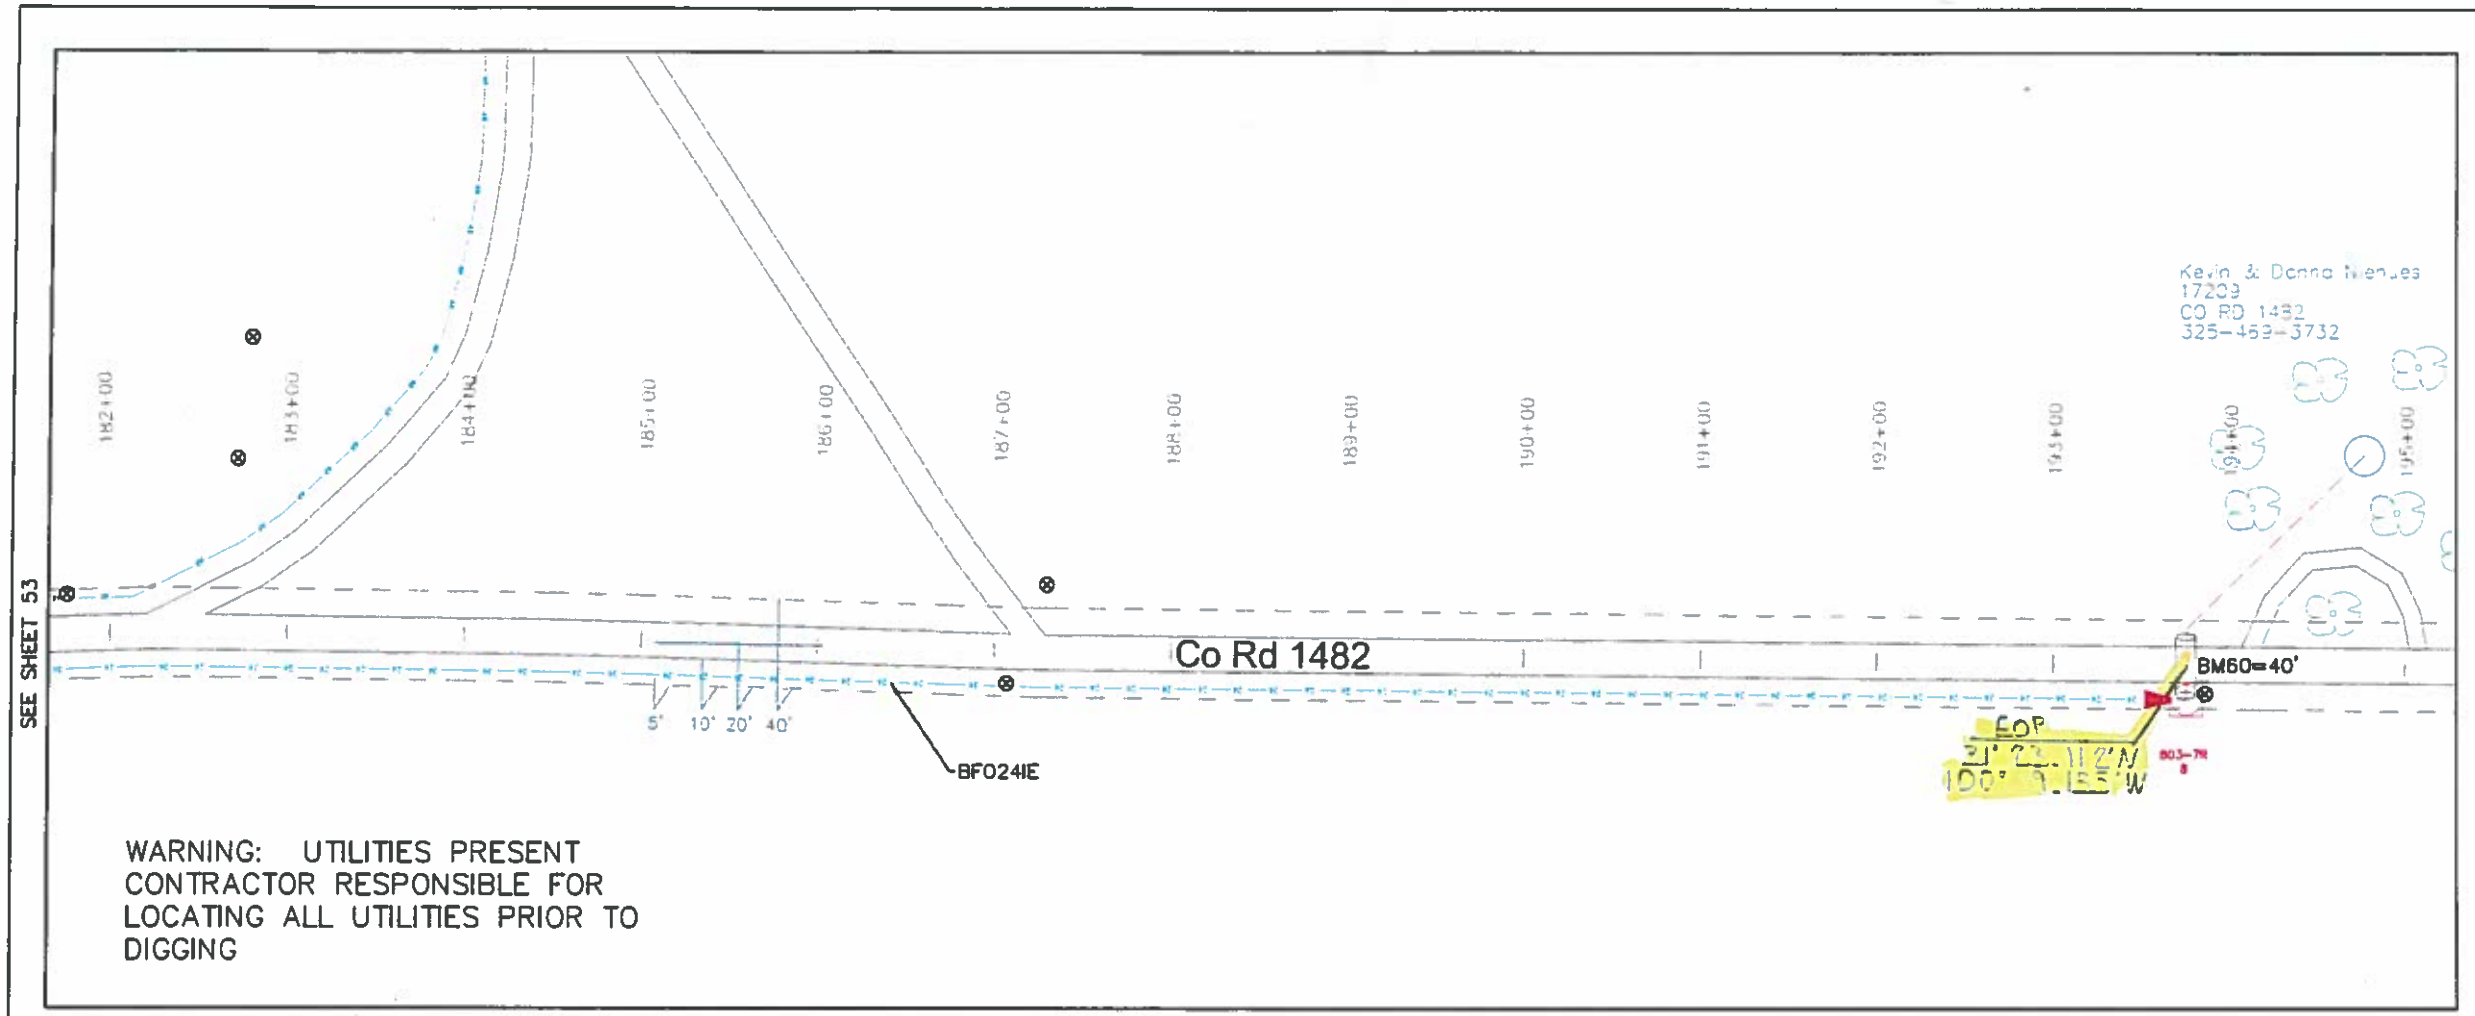

CTTC

EXCH.:	EOLA	
COUNTY:	CONCHO/TOM GREEN	
ROUTE:	803/7R	
SHEET:	13 OF 13	
PROJECT:	TX549-02	
JOB NO.:	002	
CONST. SHT.:	54 OF 63	
MAP REF.:	TX549 EOLA 803 SS	
TWP:	RGE:	SEC:
TAX DIST.:		
AS BUILT DATE:		
TAX CODES		
CITY:	CO:	
ESU:	FIRE:	
HOSP:	SCH:	
SPC:	ST:	
DRAWN BY: JMA		
REVIEWED BY:		

ROUTE	HH NO	BHF (24x36 x30)T			BFO 12I	BFO 12IE							BM 53 AF	BM 52 P	BM 55 B	BM 57 F	BM 83	BM BHF 02		BM60 (2)(1.25) D			WBMPD (1)(1.25)	HBFO (5)	BM AGW	HO 1	NID 4G	SEBPD (1.25)			SEB FO 4I	MISC. NOTES
803-7R	8	1			60	1400							1	1	1	1	1	1		40			10	1	70	2	1	80			120	
																															60	
																															10	
		1			60	1400							1	1	1	1	1	1		40			10	1	70	2	1	80			190	

N-com