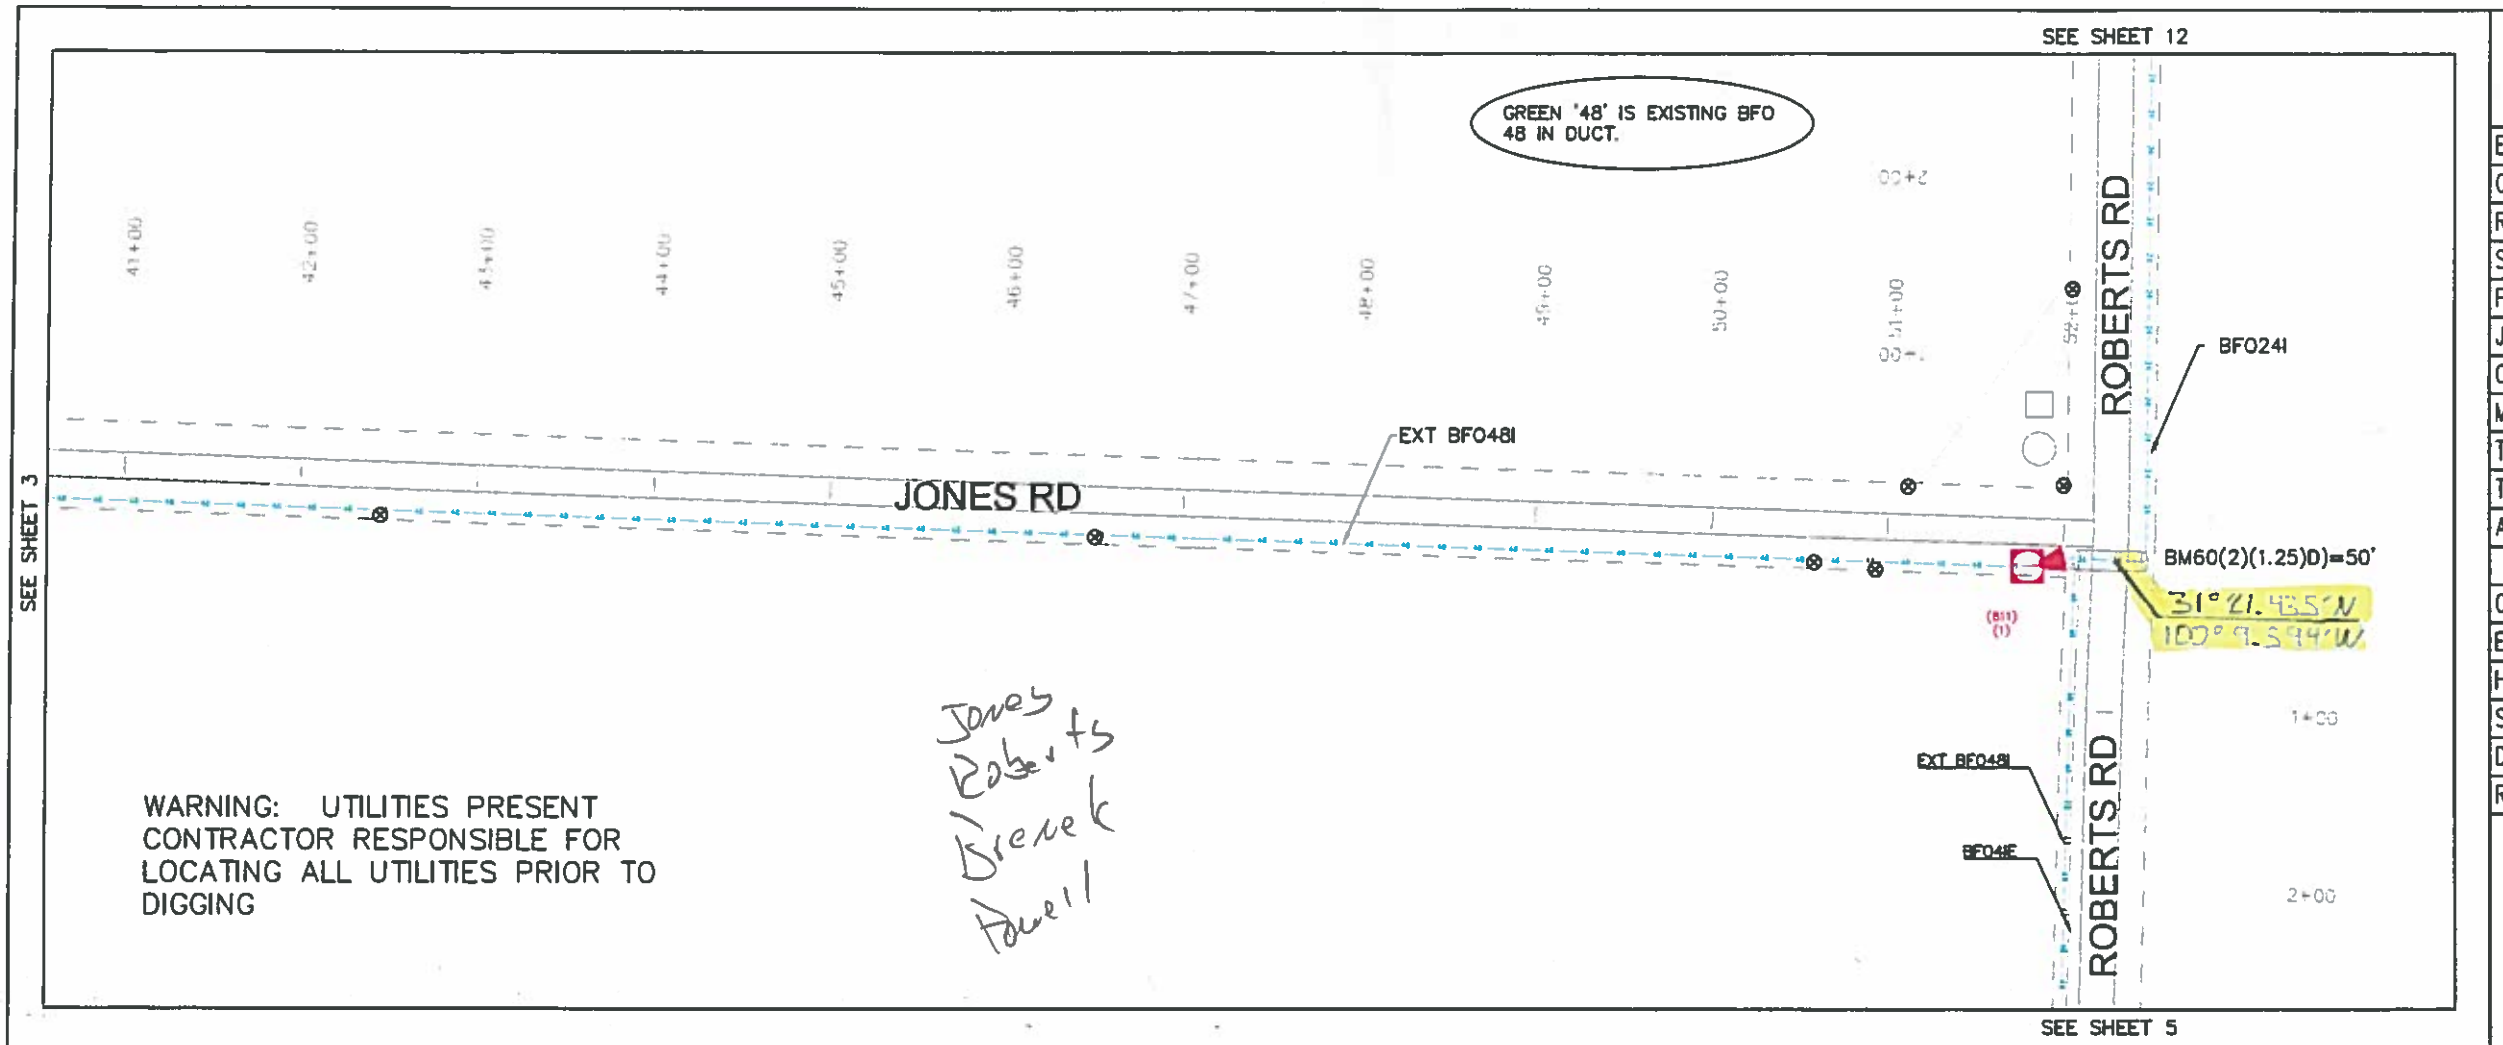

CTTC

EXCH.:	EOLA–VANCOURT
COUNTY:	CONCHO/TOM GREEN
ROUTE:	811
SHEET:	4 OF 11
PROJECT:	TX549–02
JOB NO.:	002
CONST. SHT.:	4 OF 24
MAP REF.:	TX549 EOLA 811 SS
TWP:	RGE: SEC:
TAX DIST.:	
AS BUILT DATE:	
TAX CODES	
CITY:	CO:
ESU:	FIRE:
HOSP:	SCH:
SPC:	ST:
DRAWN BY:	JMA
REVIEWED BY:	

ROUTE	HH NO				BFO 4I	BFO 24I						WBM 52 P		BM BHF 02	BM 55 B		BM 57 FR					WBHF		WBFO (W)		HO 1					
811	(1)				60	60						1		1	1		1					1		1		1					
					60	60						1		1	1		1					1		1		1					

MISC. NOTES

N-com

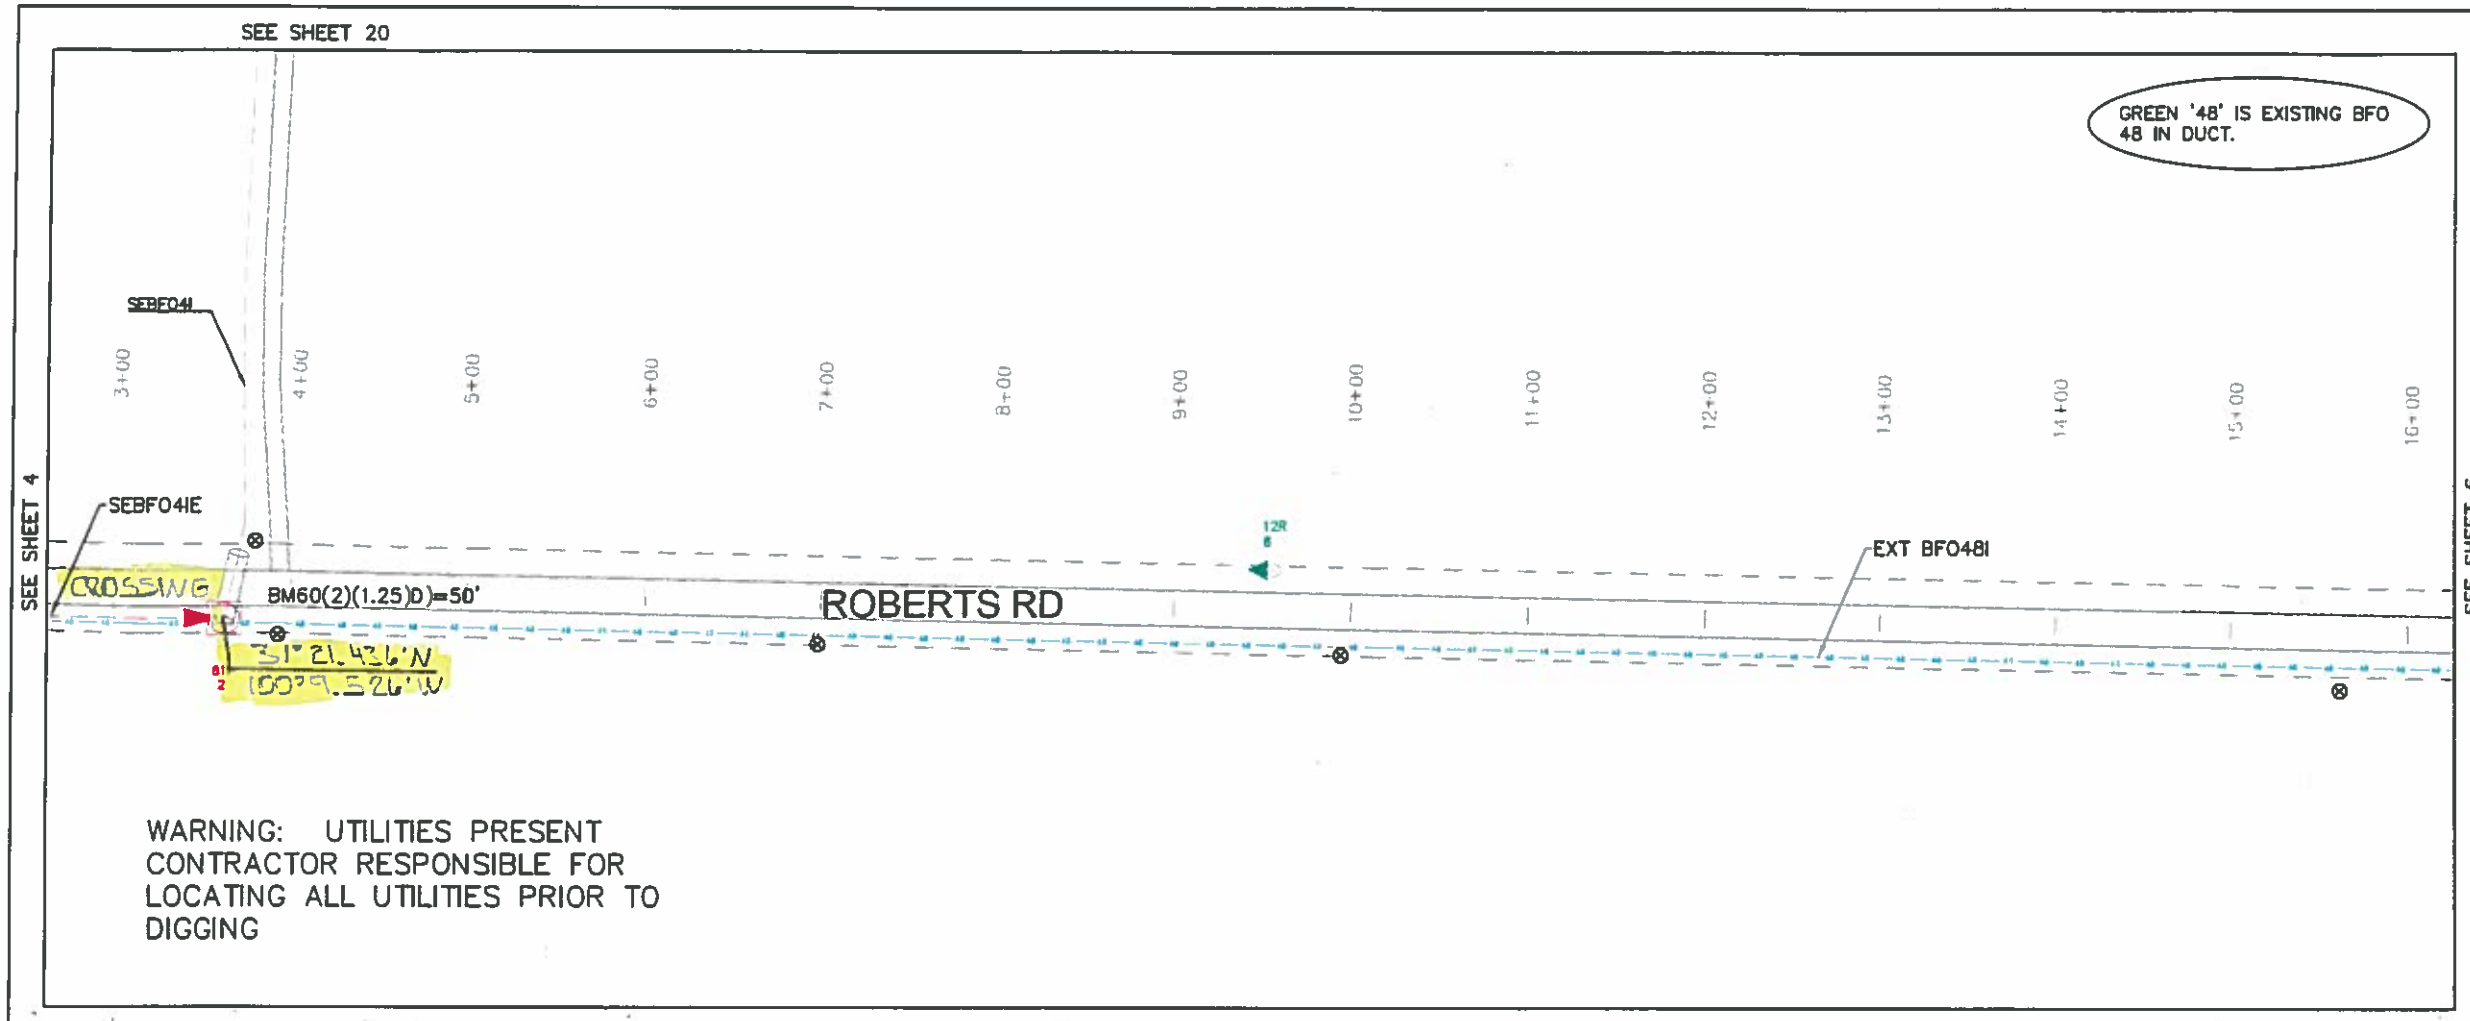

WARNING: UTILITIES PRESENT
CONTRACTOR RESPONSIBLE FOR
LOCATING ALL UTILITIES PRIOR TO
DIGGING

CTTC

EXCH.:	EOLA–VANCOURT
COUNTY:	CONCHO/TOM GREEN
ROUTE:	811
SHEET:	5 OF 11
PROJECT:	TX549–02
JOB NO.:	002
CONST. SHT.:	5 OF 24
MAP REF.:	TX549 EOLA 811 SS
TWP:	RGE: SEC:
TAX DIST.:	
AS BUILT DATE:	
TAX CODES	
CITY:	CO:
ESU:	FIRE:
HOSP:	SCH:
SPC:	ST:
DRAWN BY: JMA	
REVIEWED BY:	

MISC. NOTES

ROUTE	HH NO		BHF (30x48 x36)F										BM 53 AF	BM 52 P		BM 57 F	BM 83			BM60 (2)(1.25) D			WBMPD (1)(1.25)					SEBFO 4IE	NID 3G	SEBPD (1.25)	SEB FO 4I
811	2		1										1	1		1	1			50			10					520	1	1150	120
																															1200
																															10
			1										1	1		1	1			50			10					520	1	1150	1330

N-com

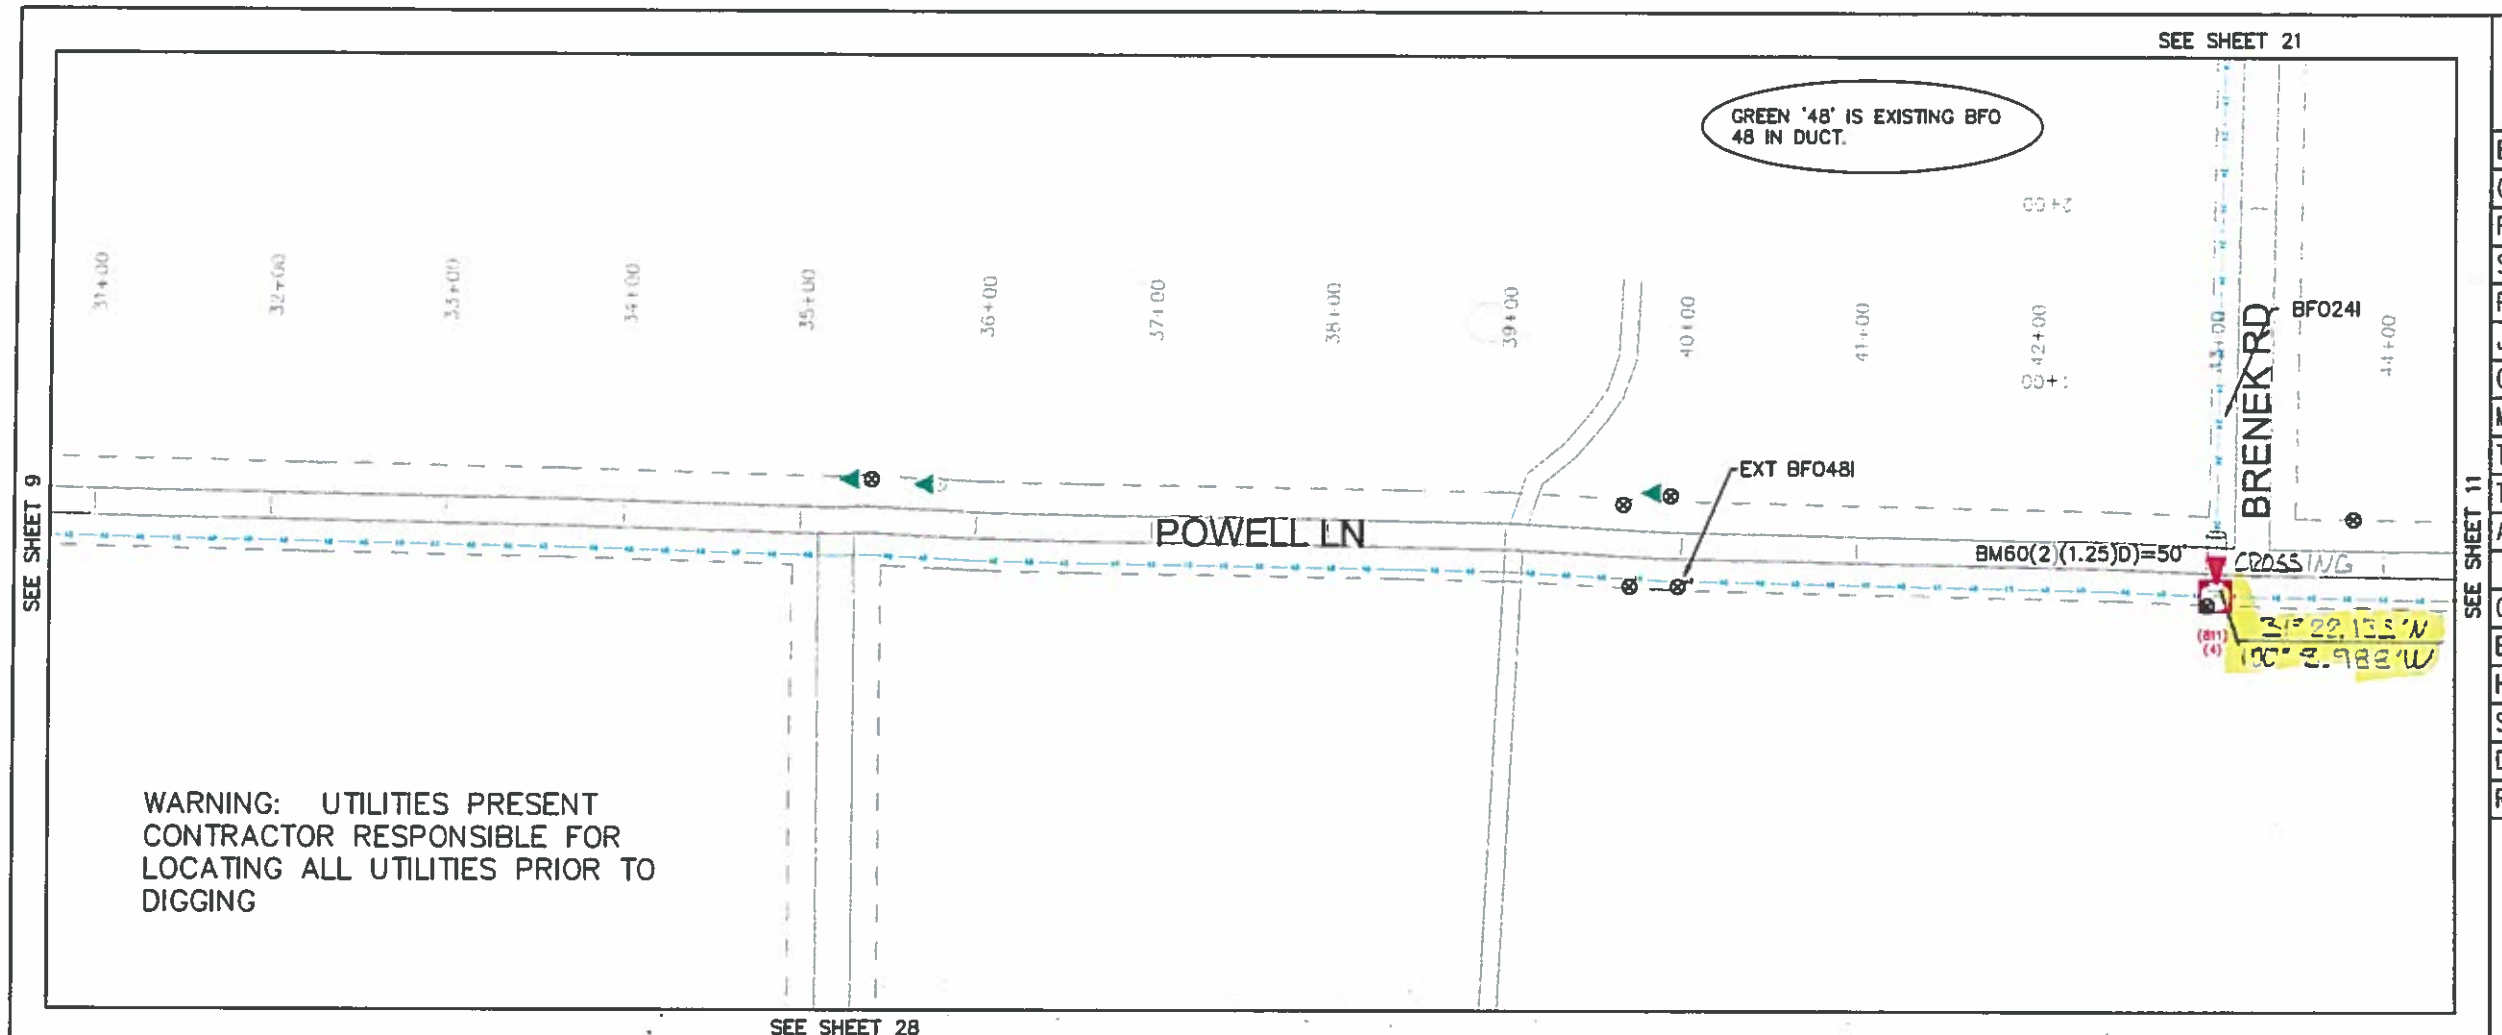

CTTC

EXCH.:	EOLA–VANCOURT
COUNTY:	CONCHO/TOM GREEN
ROUTE:	811
SHEET:	10 OF 11
PROJECT:	TX549–02
JOB NO.:	002
CONST. SHT.:	10 OF 24
MAP REF.:	TX549 EOLA 811 SS
TWP:	RGE: SEC:
TAX DIST.:	
AS BUILT DATE:	
TAX CODES	
CITY:	CO:
ESU:	FIRE:
HOSP:	SCH:
SPC:	ST:
DRAWN BY: JMA	
REVIEWED BY:	

MISC. NOTES

ROUTE	HH NO				BFO 24I							WBM 52 P	BM 8HF 02		BM 55 B		BM 57 FR					WGHF			HBFO (4)	HO 1					
811	(4)				60							1	1		1		1					1			1	4					
					60							1			1		1					1			1	4					

N-com

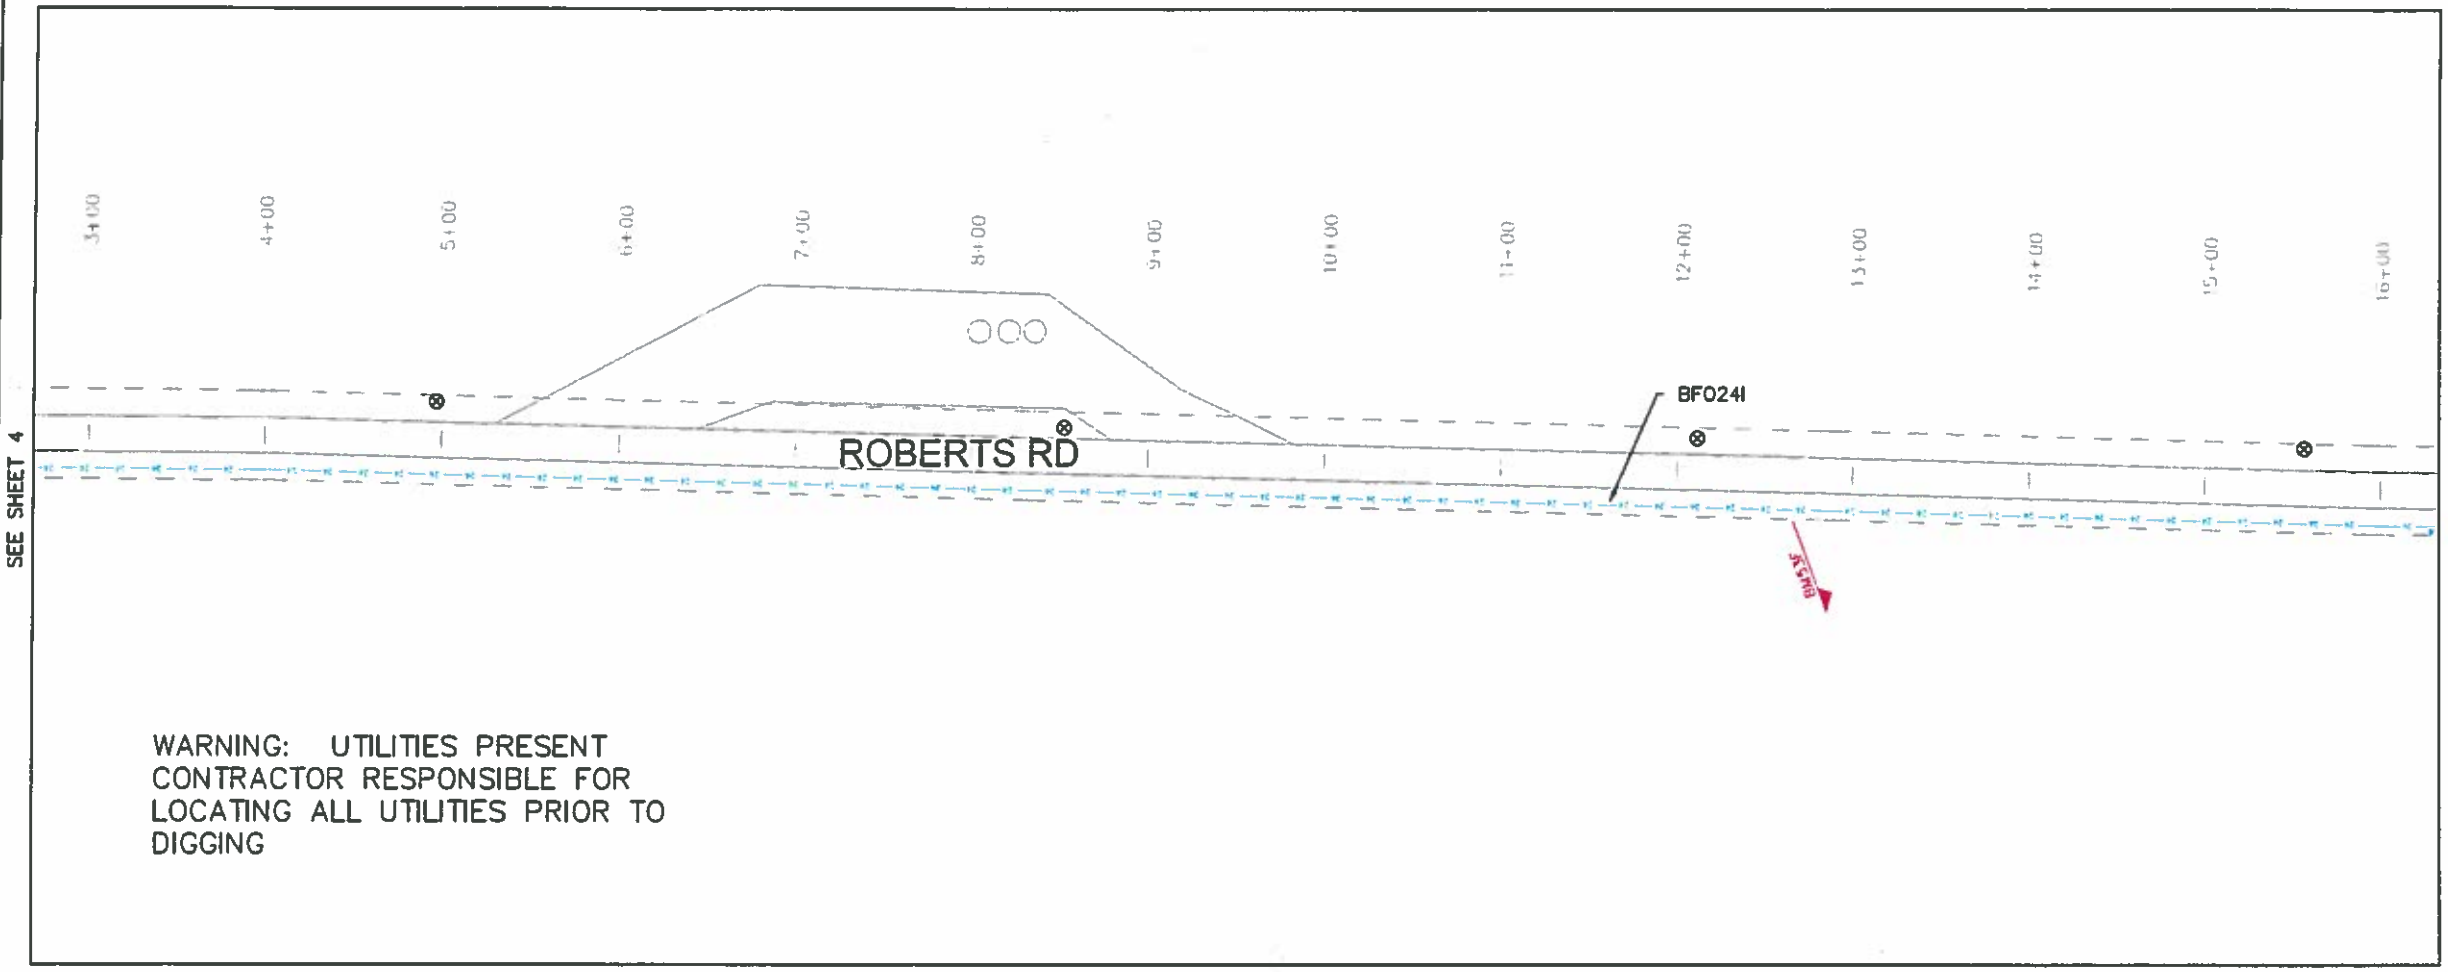

WARNING: UTILITIES PRESENT
CONTRACTOR RESPONSIBLE FOR
LOCATING ALL UTILITIES PRIOR TO
DIGGING

CTTC

EXCH.:	EOLA–VANCOURT
COUNTY:	CONCHO/TOM GREEN
ROUTE:	811–1
SHEET:	1 OF 8
PROJECT:	TX549–02
JOB NO.:	002
CONST. SHT.:	12 OF 24
MAP REF.:	TX549 EOLA 811 SS
TWP:	RGE: SEC:
TAX DIST.:	
AS BUILT DATE:	
TAX CODES	
CITY:	CO:
ESU:	FIRE:
HOSP:	SCH:
SPC:	ST:
DRAWN BY: JMA	
REVIEWED BY:	

ROUTE	HH NO
811–1	

MISC. NOTES

N-com

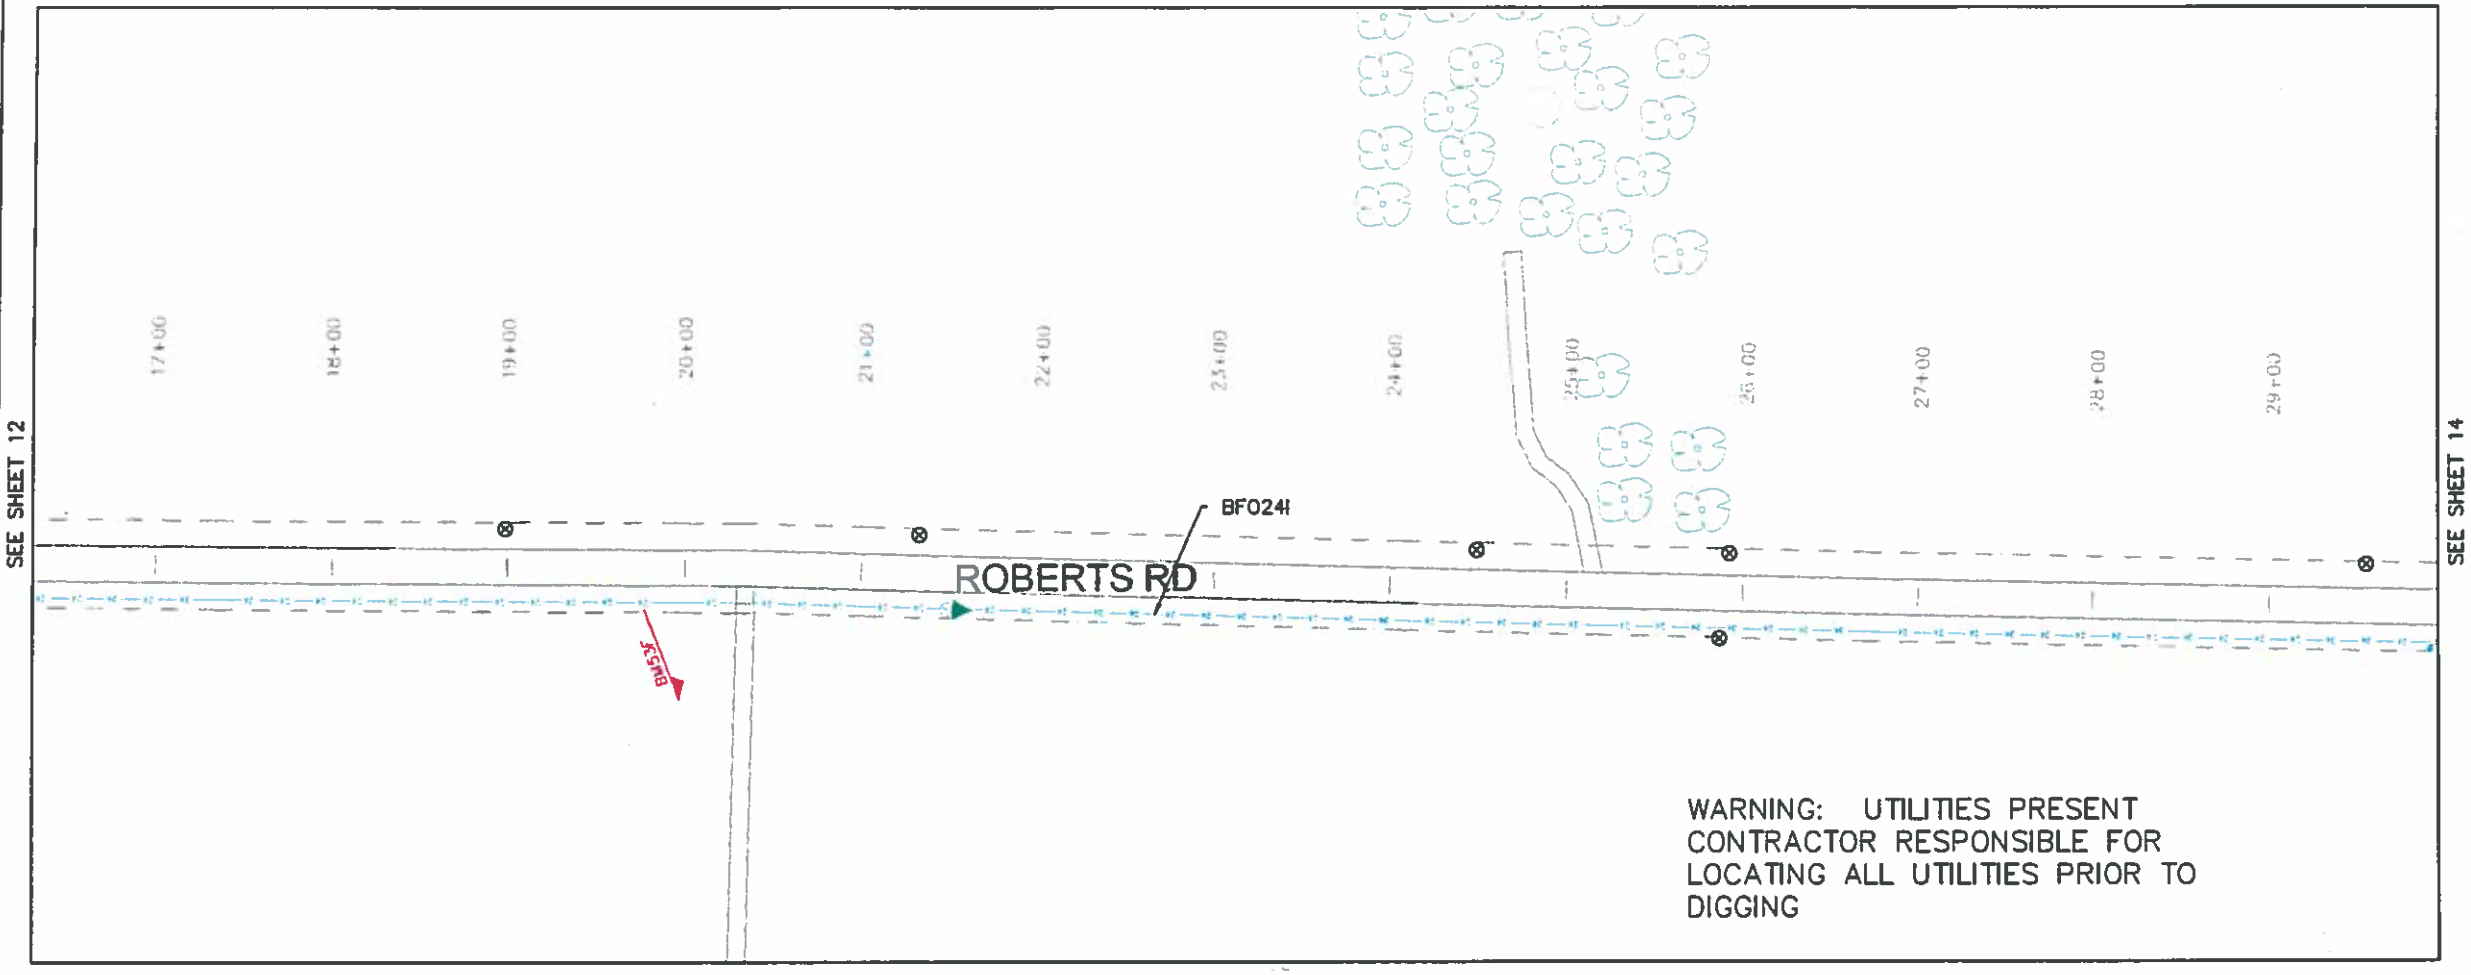

CTTC

EXCH.:	EOLA–VANCOURT
COUNTY:	CONCHO/TOM GREEN
ROUTE:	811–1
SHEET:	2 OF 8
PROJECT:	TX549–02
JOB NO.:	002
CONST. SHT.:	13 OF 24
MAP REF.:	TX549 EOLA 811 SS
TWP:	RGE: SEC:
TAX DIST.:	
AS BUILT DATE:	
TAX CODES	
CITY:	CO:
ESU:	FIRE:
HOSP:	SCH:
SPC:	ST:
DRAWN BY: JMA	
REVIEWED BY:	

ROUTE	HH NO
811–1	(1)

MISC. NOTES

N-com

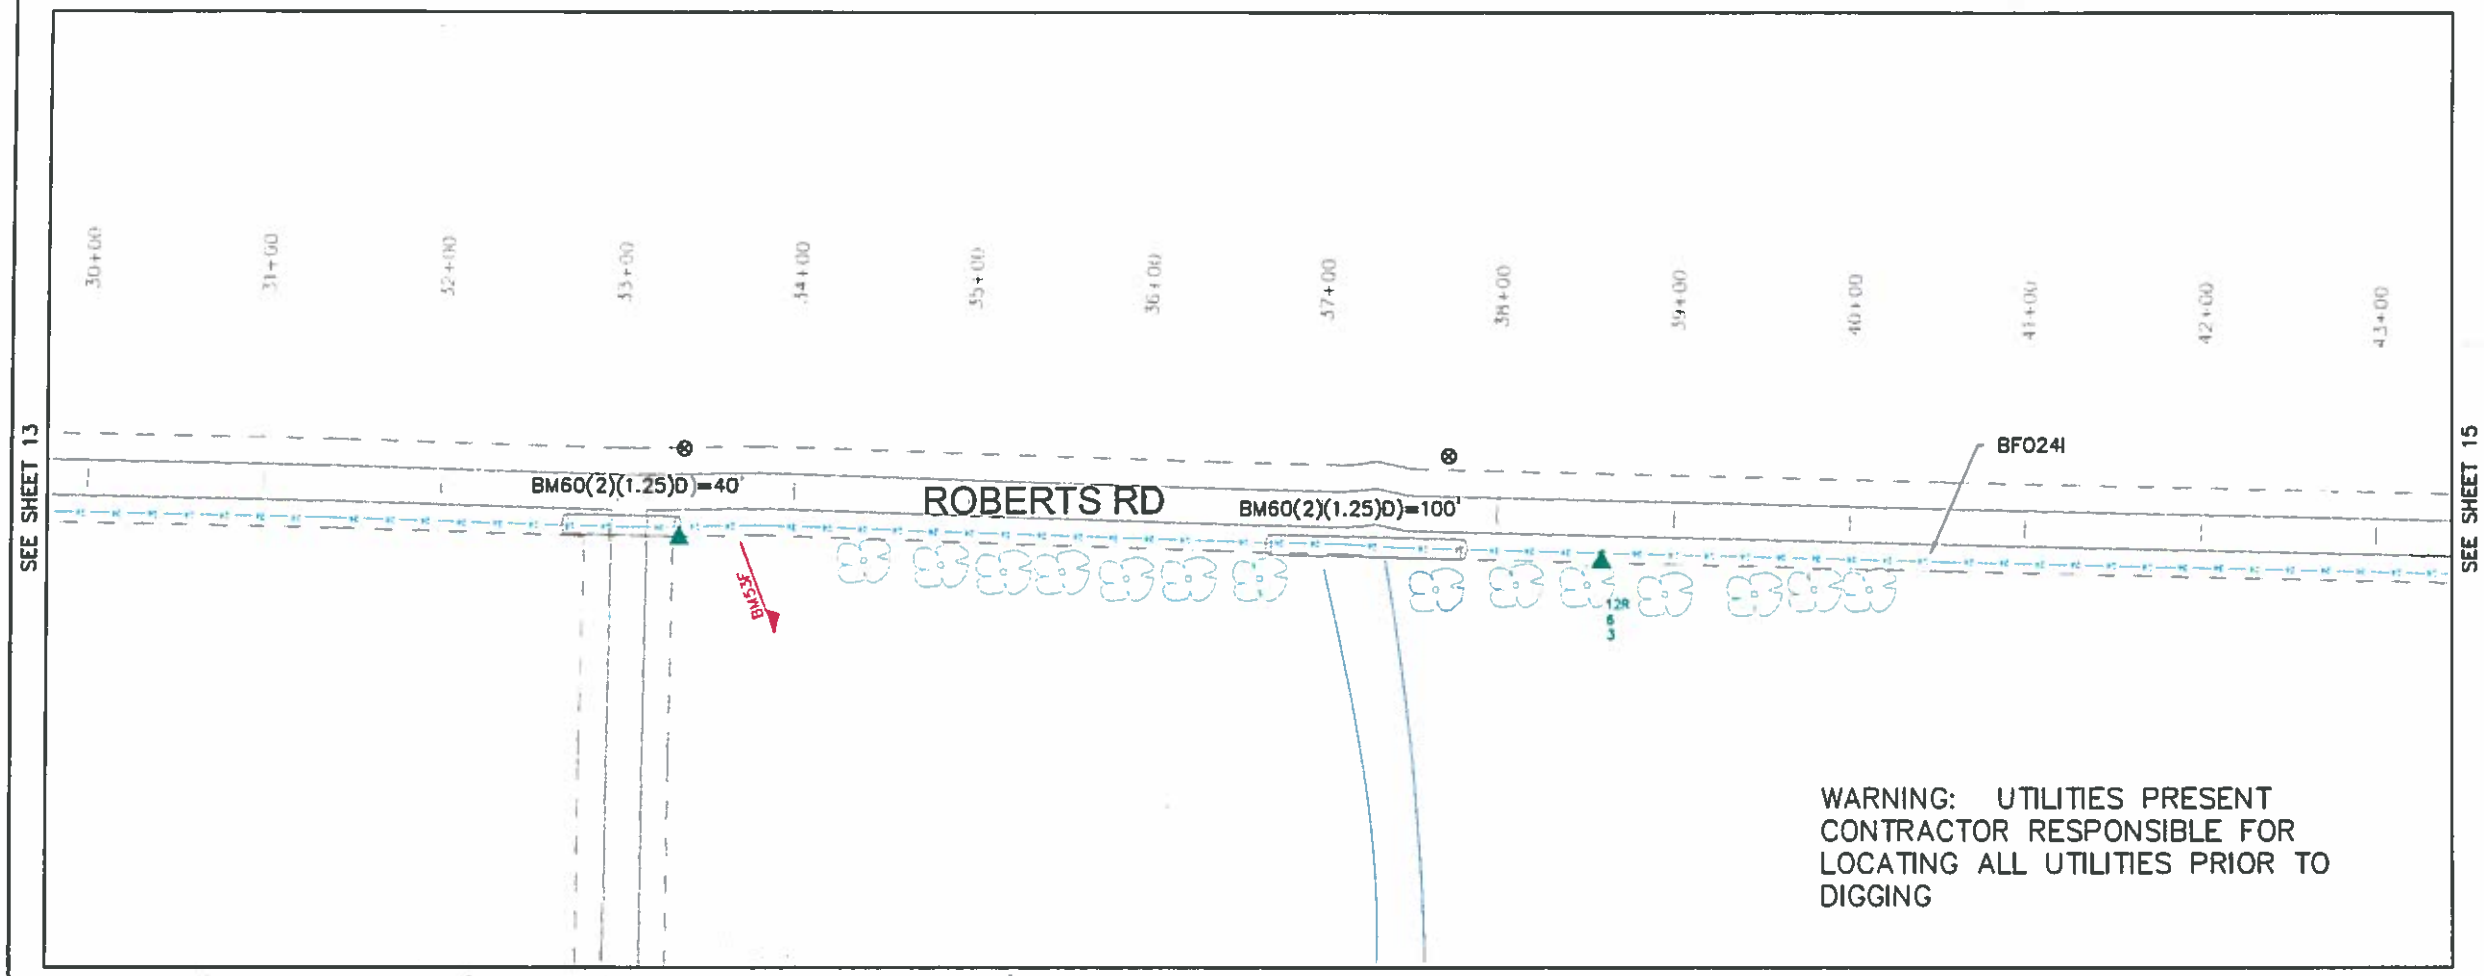

CTTC

EXCH.:	EOLA–VANCOURT
COUNTY:	CONCHO/TOM GREEN
ROUTE:	811–1
SHEET:	3 OF 8
PROJECT:	TX549–02
JOB NO.:	002
CONST. SHT.:	14 OF 24
MAP REF.:	TX549 EOLA 811 SS
TWP:	RGE: SEC:
TAX DIST.:	
AS BUILT DATE:	
TAX CODES	
CITY:	CO:
ESU:	FIRE:
HOSP:	SCH:
SPC:	ST:
DRAWN BY: JMA	
REVIEWED BY:	

ROUTE	HH NO
811–1	(1)

MISC. NOTES

N-com

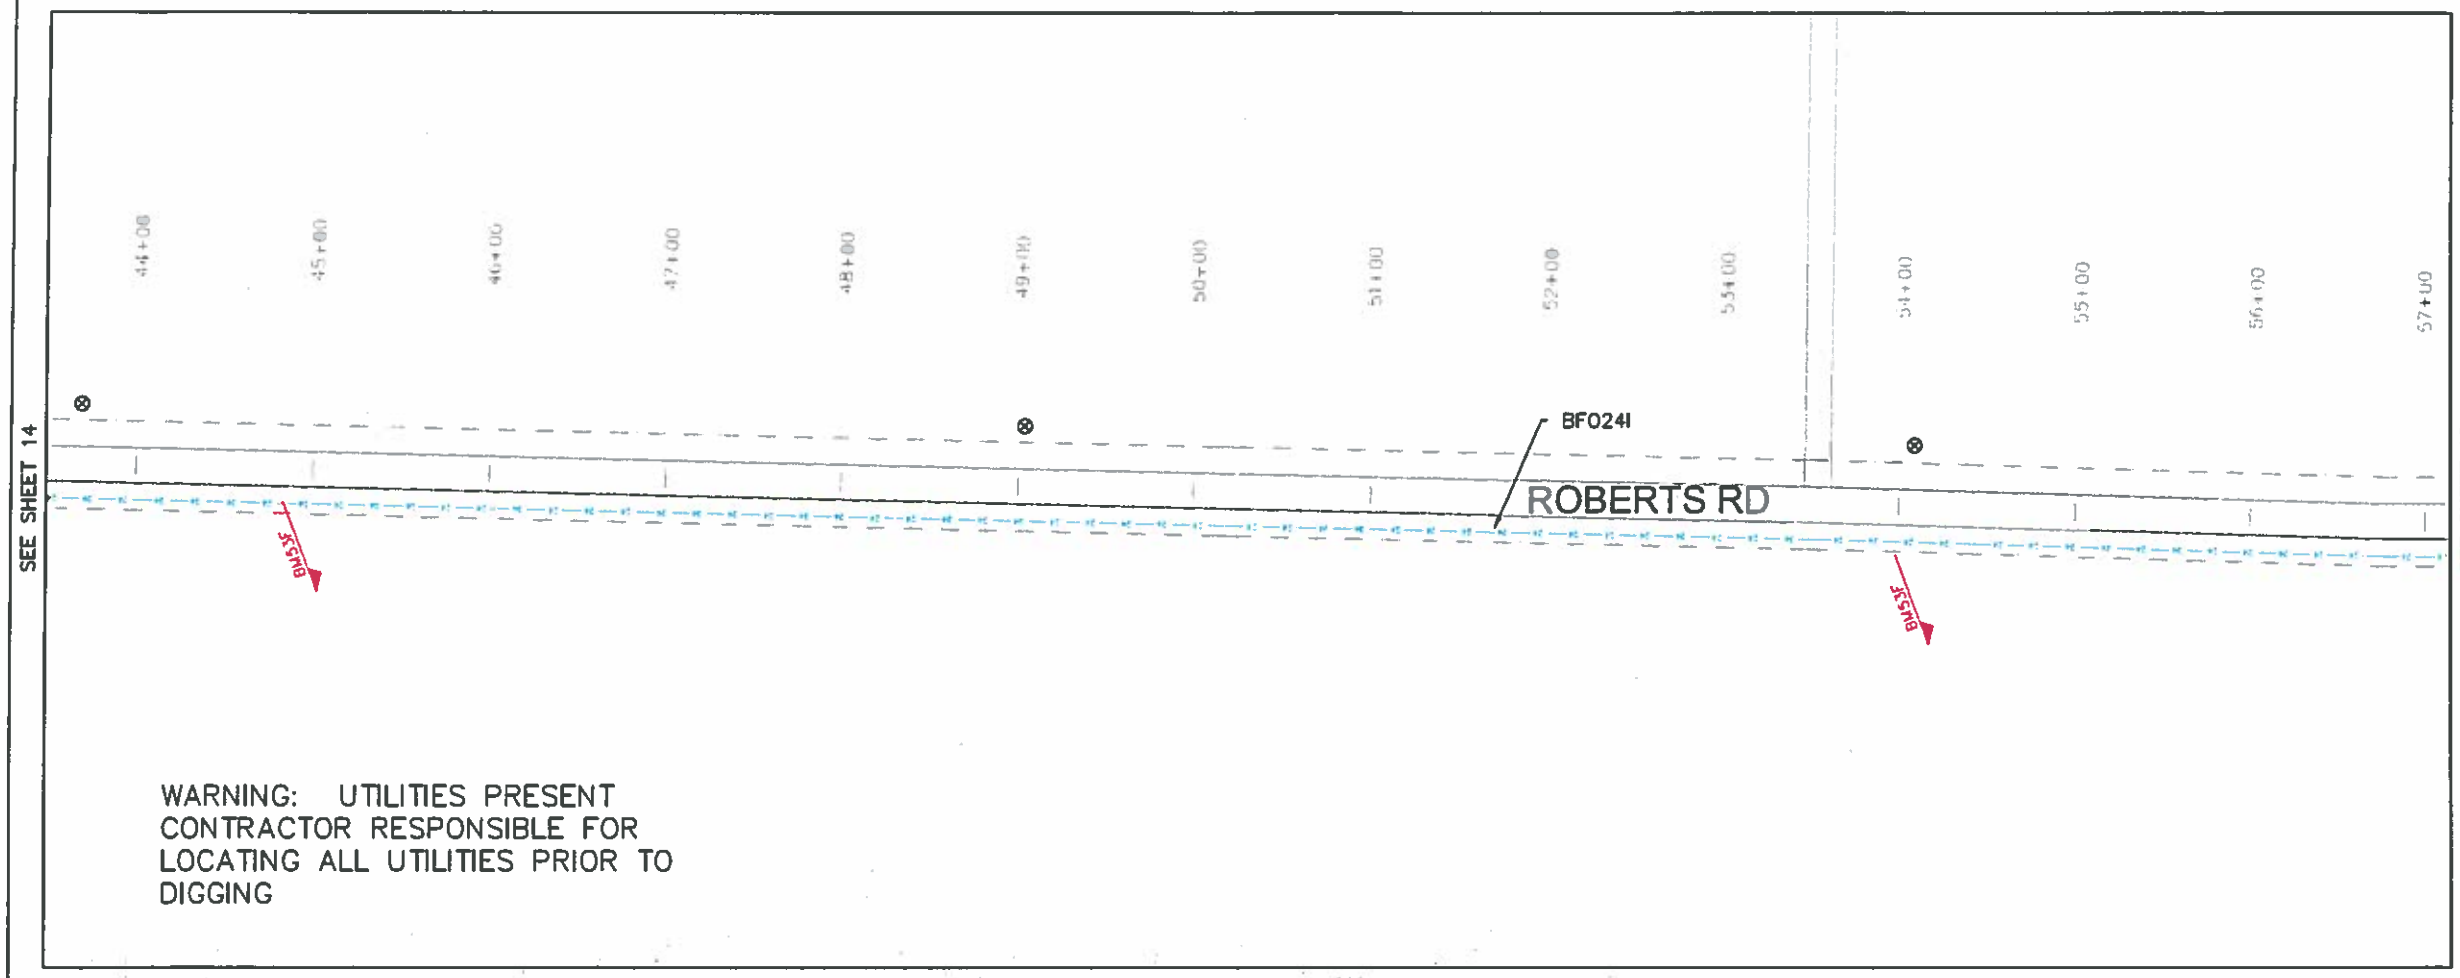

CTTC

EXCH.:	EOLA–VANCOURT
COUNTY:	CONCHO/TOM GREEN
ROUTE:	811–1
SHEET:	4 OF 8
PROJECT:	TX549–02
JOB NO.:	002
CONST. SHT.:	15 OF 24
MAP REF.:	TX549 EOLA 811 SS
TWP:	RGE: SEC:
TAX DIST.:	
AS BUILT DATE:	
TAX CODES	
CITY:	CO:
ESU:	FIRE:
HOSP:	SCH:
SPC:	ST:
DRAWN BY: JMA	
REVIEWED BY:	

ROUTE	HH NO
811–1	(1)

MISC. NOTES

N-com

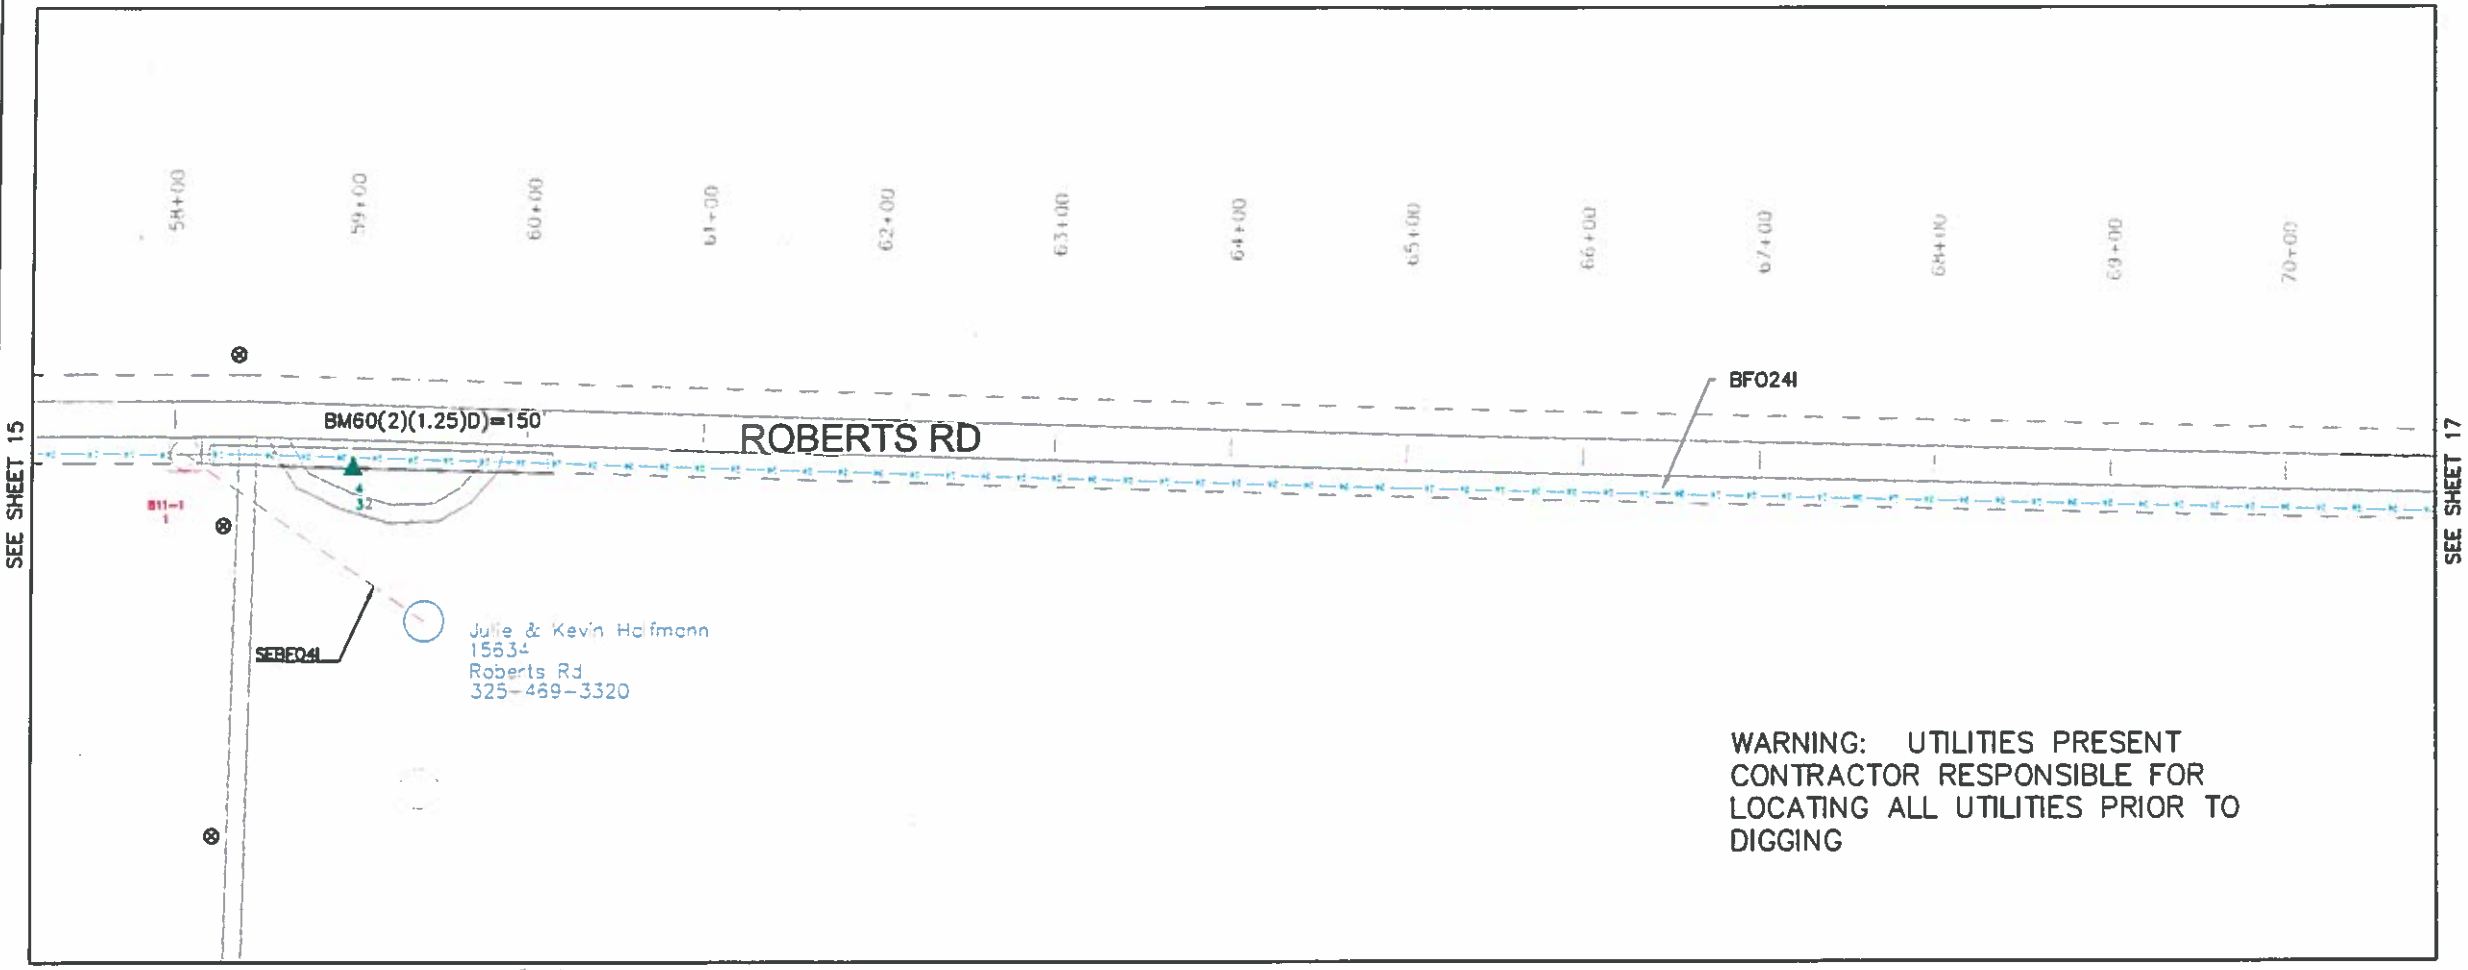

CTTC

EXCH.:	EOLA-VANCOURT
COUNTY:	CONCHO/TOM GREEN
ROUTE:	811-1
SHEET:	5 OF 8
PROJECT:	TX549-02
JOB NO.:	002
CONST. SHT.:	16 OF 24
MAP REF.:	TX549 EOLA 811 SS
TWP:	RGE: SEC:
TAX DIST.:	
AS BUILT DATE:	
TAX CODES	
CITY:	CO:
ESU:	FIRE:
HOSP:	SCH:
SPC:	ST:
DRAWN BY: JMA	
REVIEWED BY:	

ROUTE	HH NO		BHF (30x48 x36)F		BFO 241					BM BHF 02	BMPD (2)(1.25)	BM 53 F	BM 53 AF	BM 52 P	BM 55 B	BM 57 F		BM 83	BM 71		BM60 (2) (1.25) D				HGFO (U)	HO 1	NID 3G	SEBPD (1.25)			SEB FO 41	MISC. NOTES
811-1	1		1		6050					1	5850	5	1	1	1	1		1	300		50				1	2	1	260			260	
					120																40										60	
																					110										10	
			1		6170					1	5850	5	1	1	1	1		1	300		200				1	2	1	260			330	

N-com

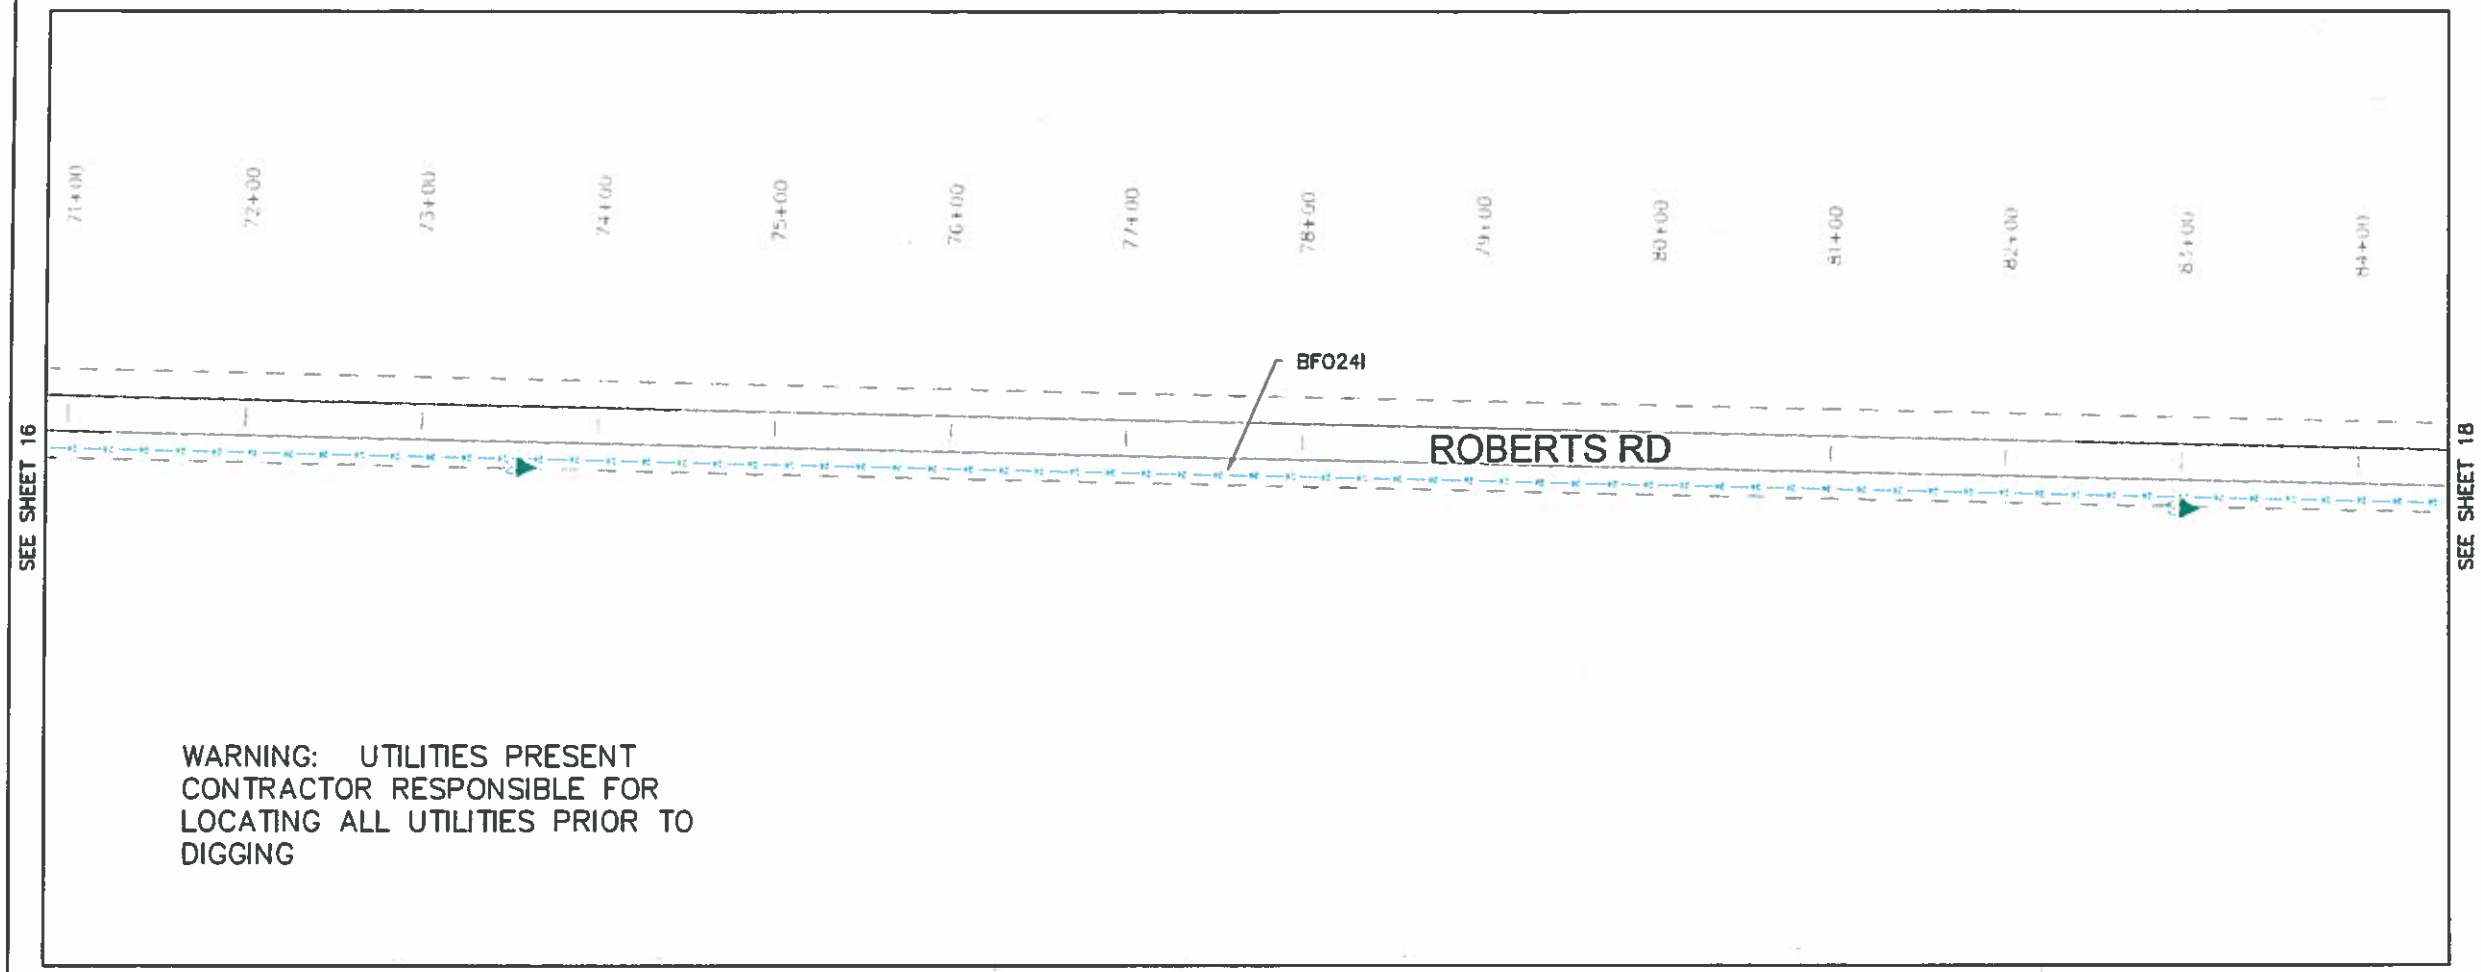

CTTC

EXCH.:	EOLA–VANCOURT
COUNTY:	CONCHO/TOM GREEN
ROUTE:	811–1
SHEET:	6 OF 8
PROJECT:	TX549–02
JOB NO.:	002
CONST. SHT.:	17 OF 24
MAP REF.:	TX549 EOLA 811 SS
TWP:	RGE: SEC:
TAX DIST.:	
AS BUILT DATE:	
TAX CODES	
CITY:	CO:
ESU:	FIRE:
HOSP:	SCH:
SPC:	ST:
DRAWN BY: JMA	
REVIEWED BY:	

ROUTE	HH NO
811–1	(1)

MISC. NOTES

N-com

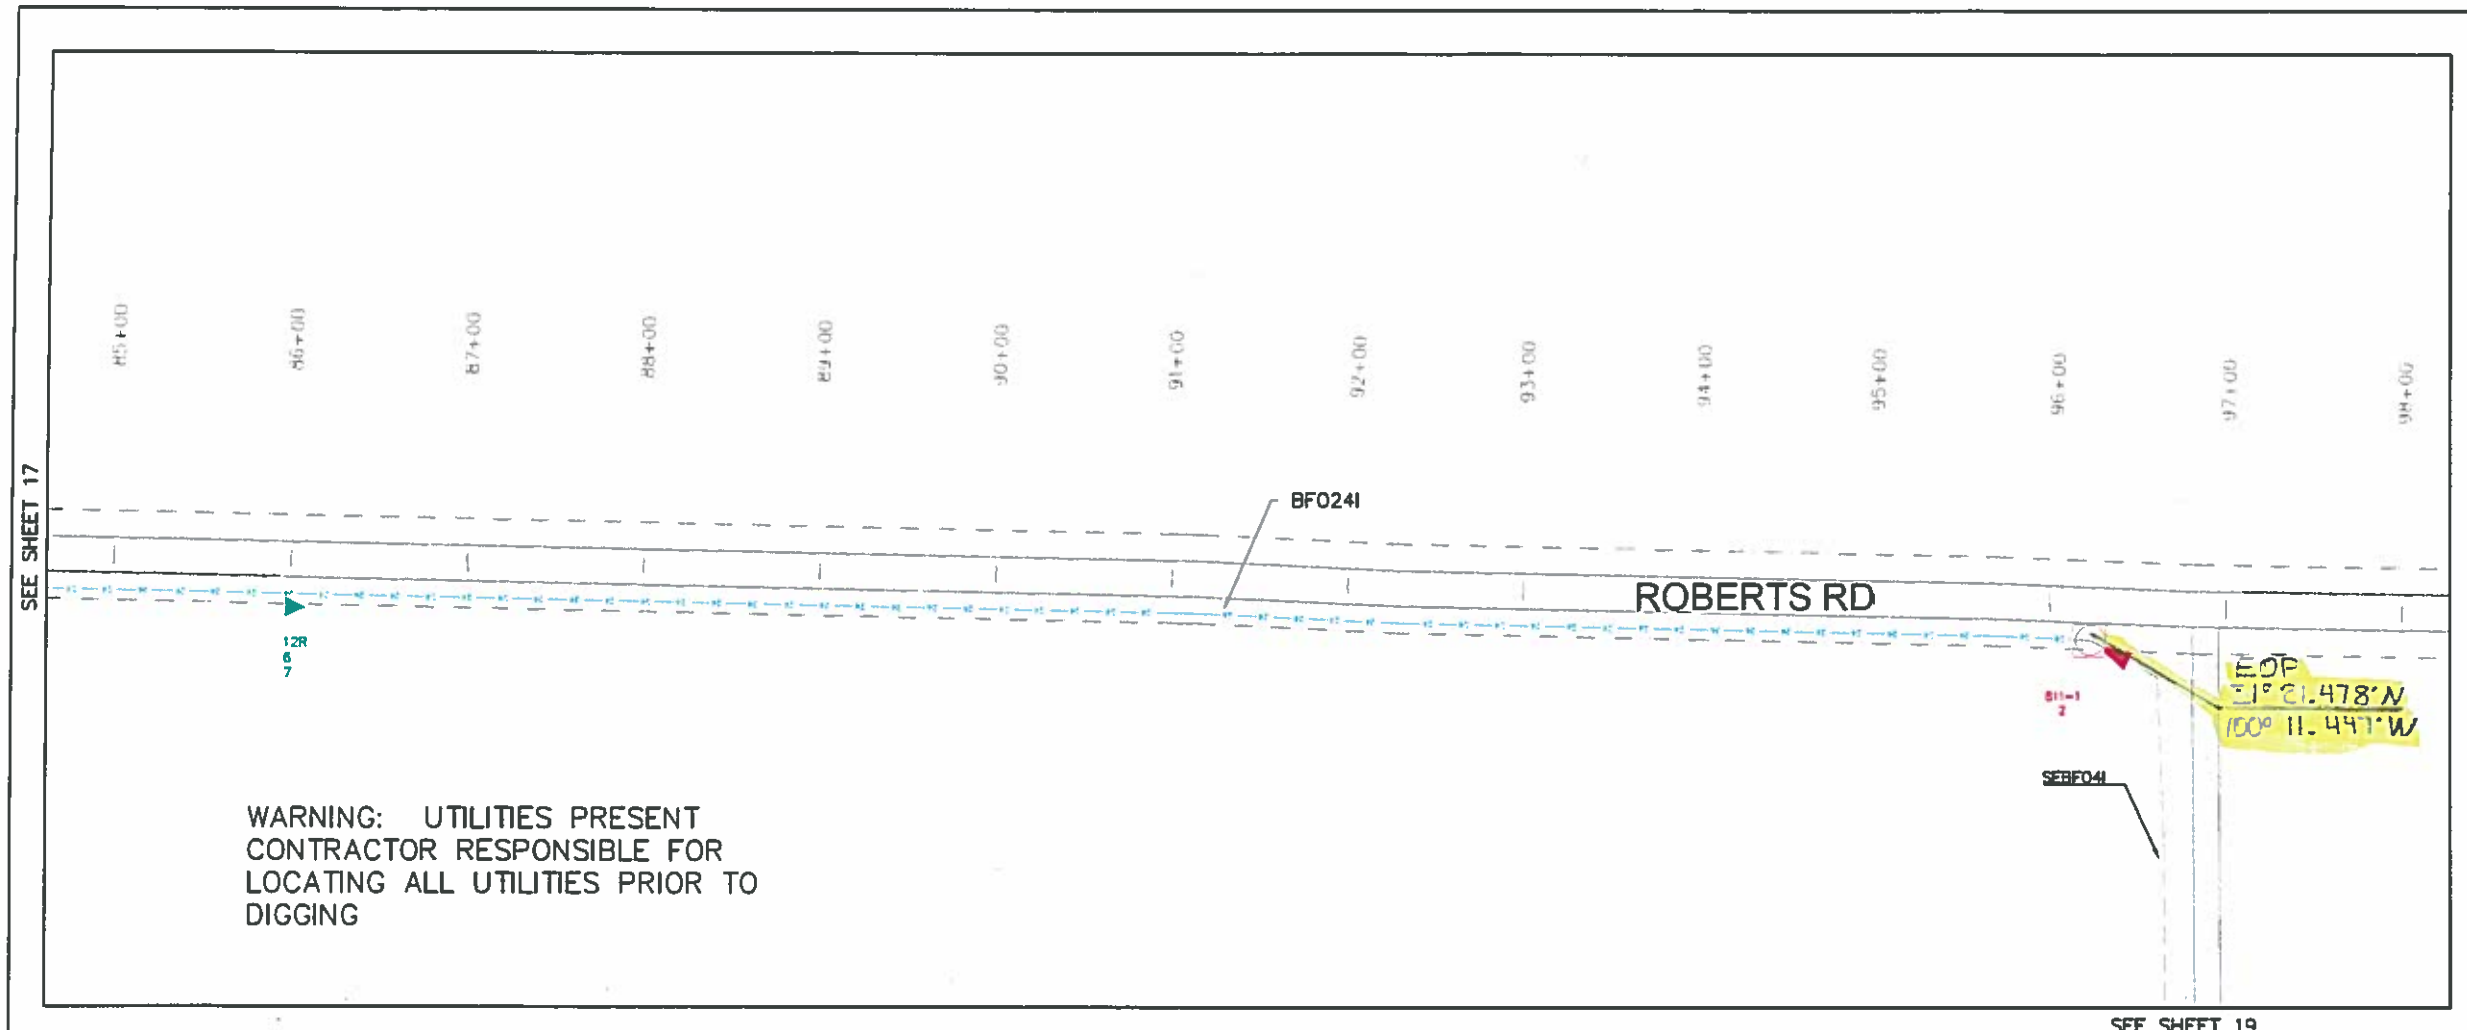

CTTC

EXCH.:	EOLA–VANCOURT
COUNTY:	CONCHO/TOM GREEN
ROUTE:	811–1
SHEET:	7 OF 8
PROJECT:	TX549–02
JOB NO.:	002
CONST. SHT.:	18 OF 24
MAP REF.:	TX549 EOLA 811 SS
TWP:	RGE: SEC:
TAX DIST.:	
AS BUILT DATE:	
TAX CODES	
CITY:	CO:
ESU:	FIRE:
HOSP:	SCH:
SPC:	ST:
DRAWN BY: JMA	
REVIEWED BY:	

ROUTE	HH NO		BHF (30x48 x36)T		BFO 241					BM BHF 02	BMPD(1 X1.25)		BM 53 AF	BM 52 P	BM 55 B	BM 57 F	BM 53 F	W BM 53 F	BM 83						HBFO(S)	HO 1		BM60 (2) (1.25) D	NID 3G	SEBPD (1) (1.25)	SEB FO 41
811–1	2		1		3840					1	3690		1	1	1	1	3	1	1						1	2		150	1	500	60
					60																										500
																															10
			1		3900					1	3690		1	1	1	1	3	1	1						1	2		150	1	500	570

MISC. NOTES

N-com

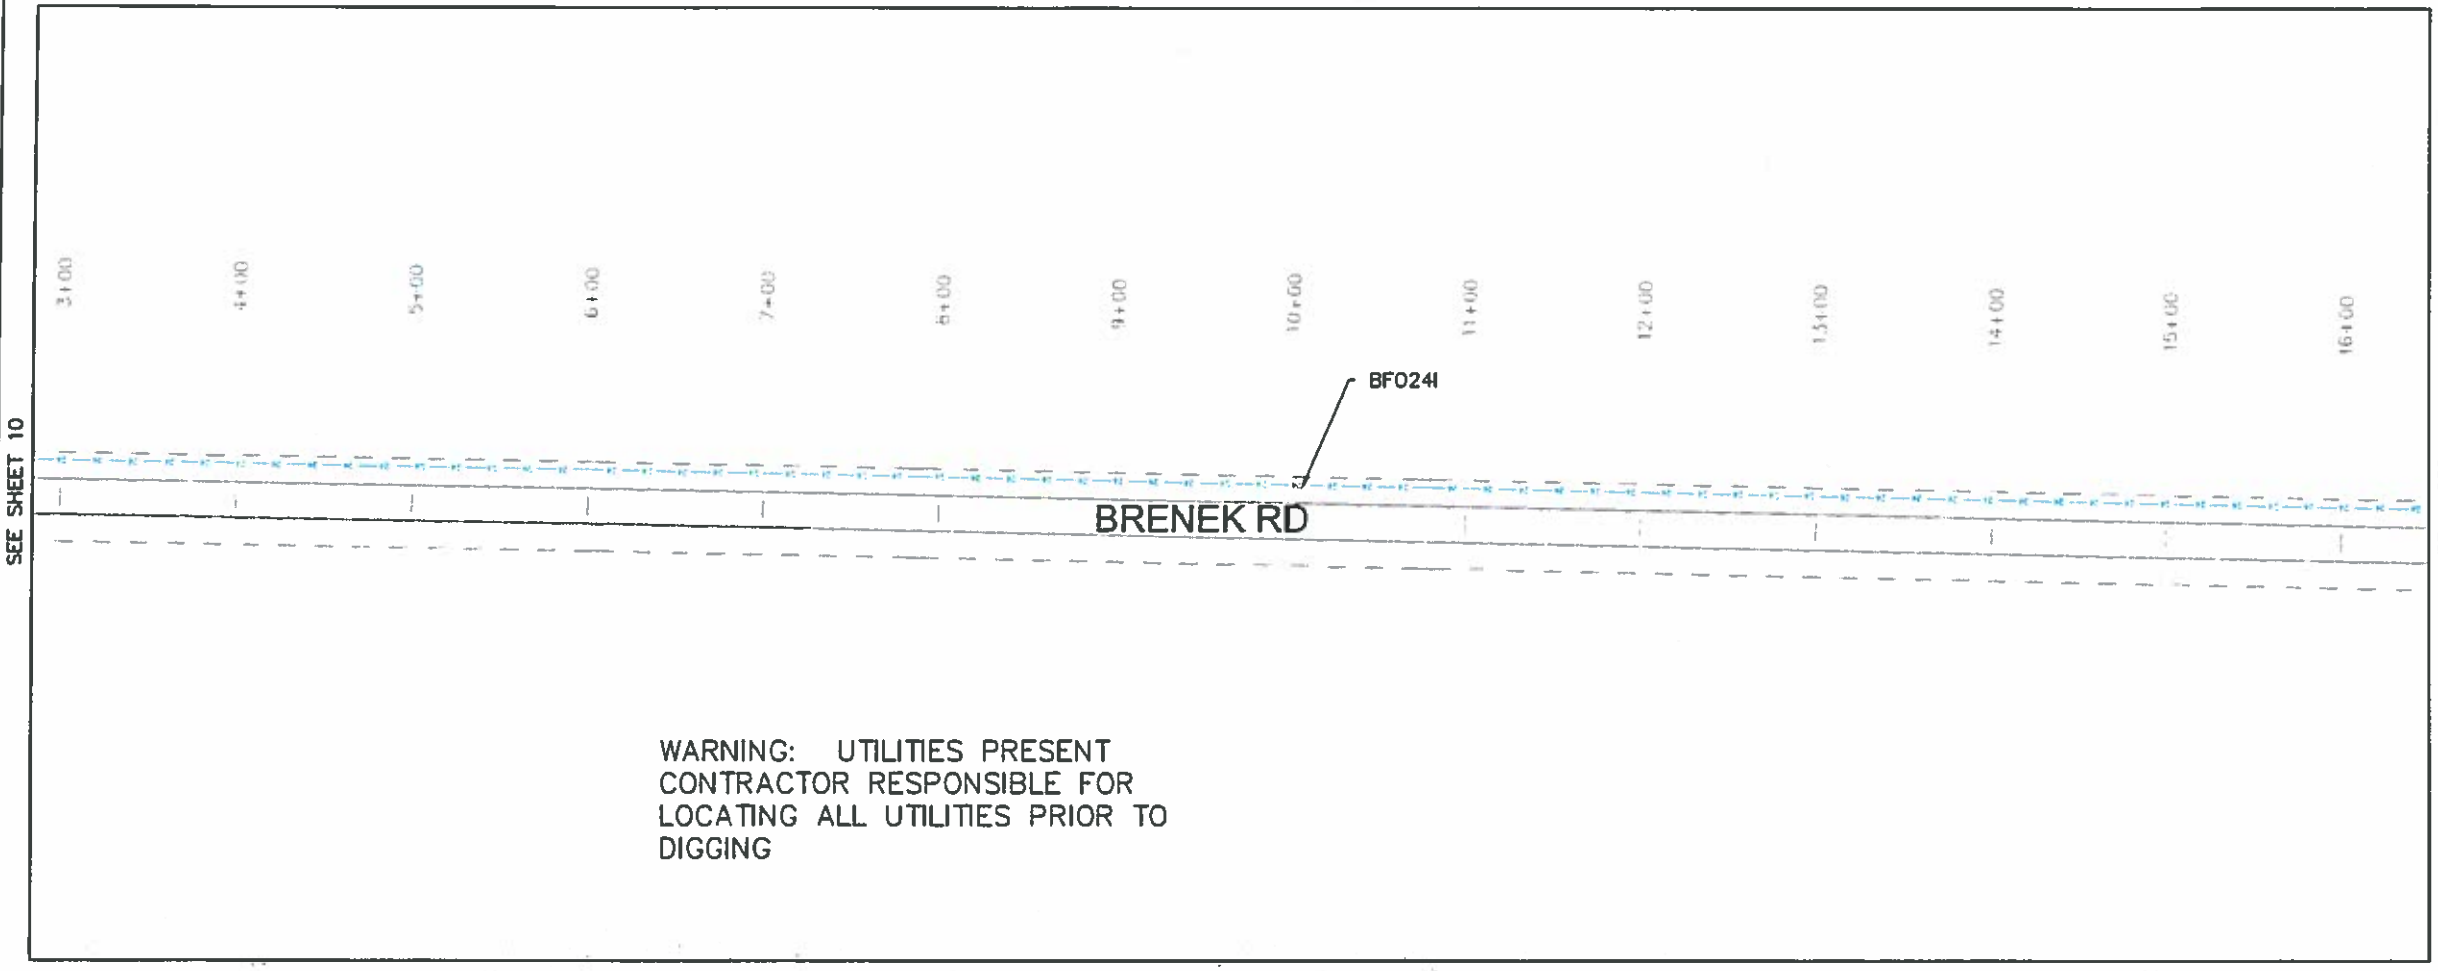

WARNING: UTILITIES PRESENT
CONTRACTOR RESPONSIBLE FOR
LOCATING ALL UTILITIES PRIOR TO
DIGGING

CTTC

EXCH.:	EOLA–VANCOURT
COUNTY:	CONCHO/TOM GREEN
ROUTE:	811–4
SHEET:	1 OF 4
PROJECT:	TX549–02
JOB NO.:	002
CONST. SHT.:	21 OF 24
MAP REF.:	TX549 EOLA 811 SS
TWP:	RGE: SEC:
TAX DIST.:	
AS BUILT DATE:	
TAX CODES	
CITY:	CO:
ESU:	FIRE:
HOSP:	SCH:
SPC:	ST:
DRAWN BY: JMA	
REVIEWED BY:	

ROUTE	HH NO
811	(4)

MISC. NOTES

N-com

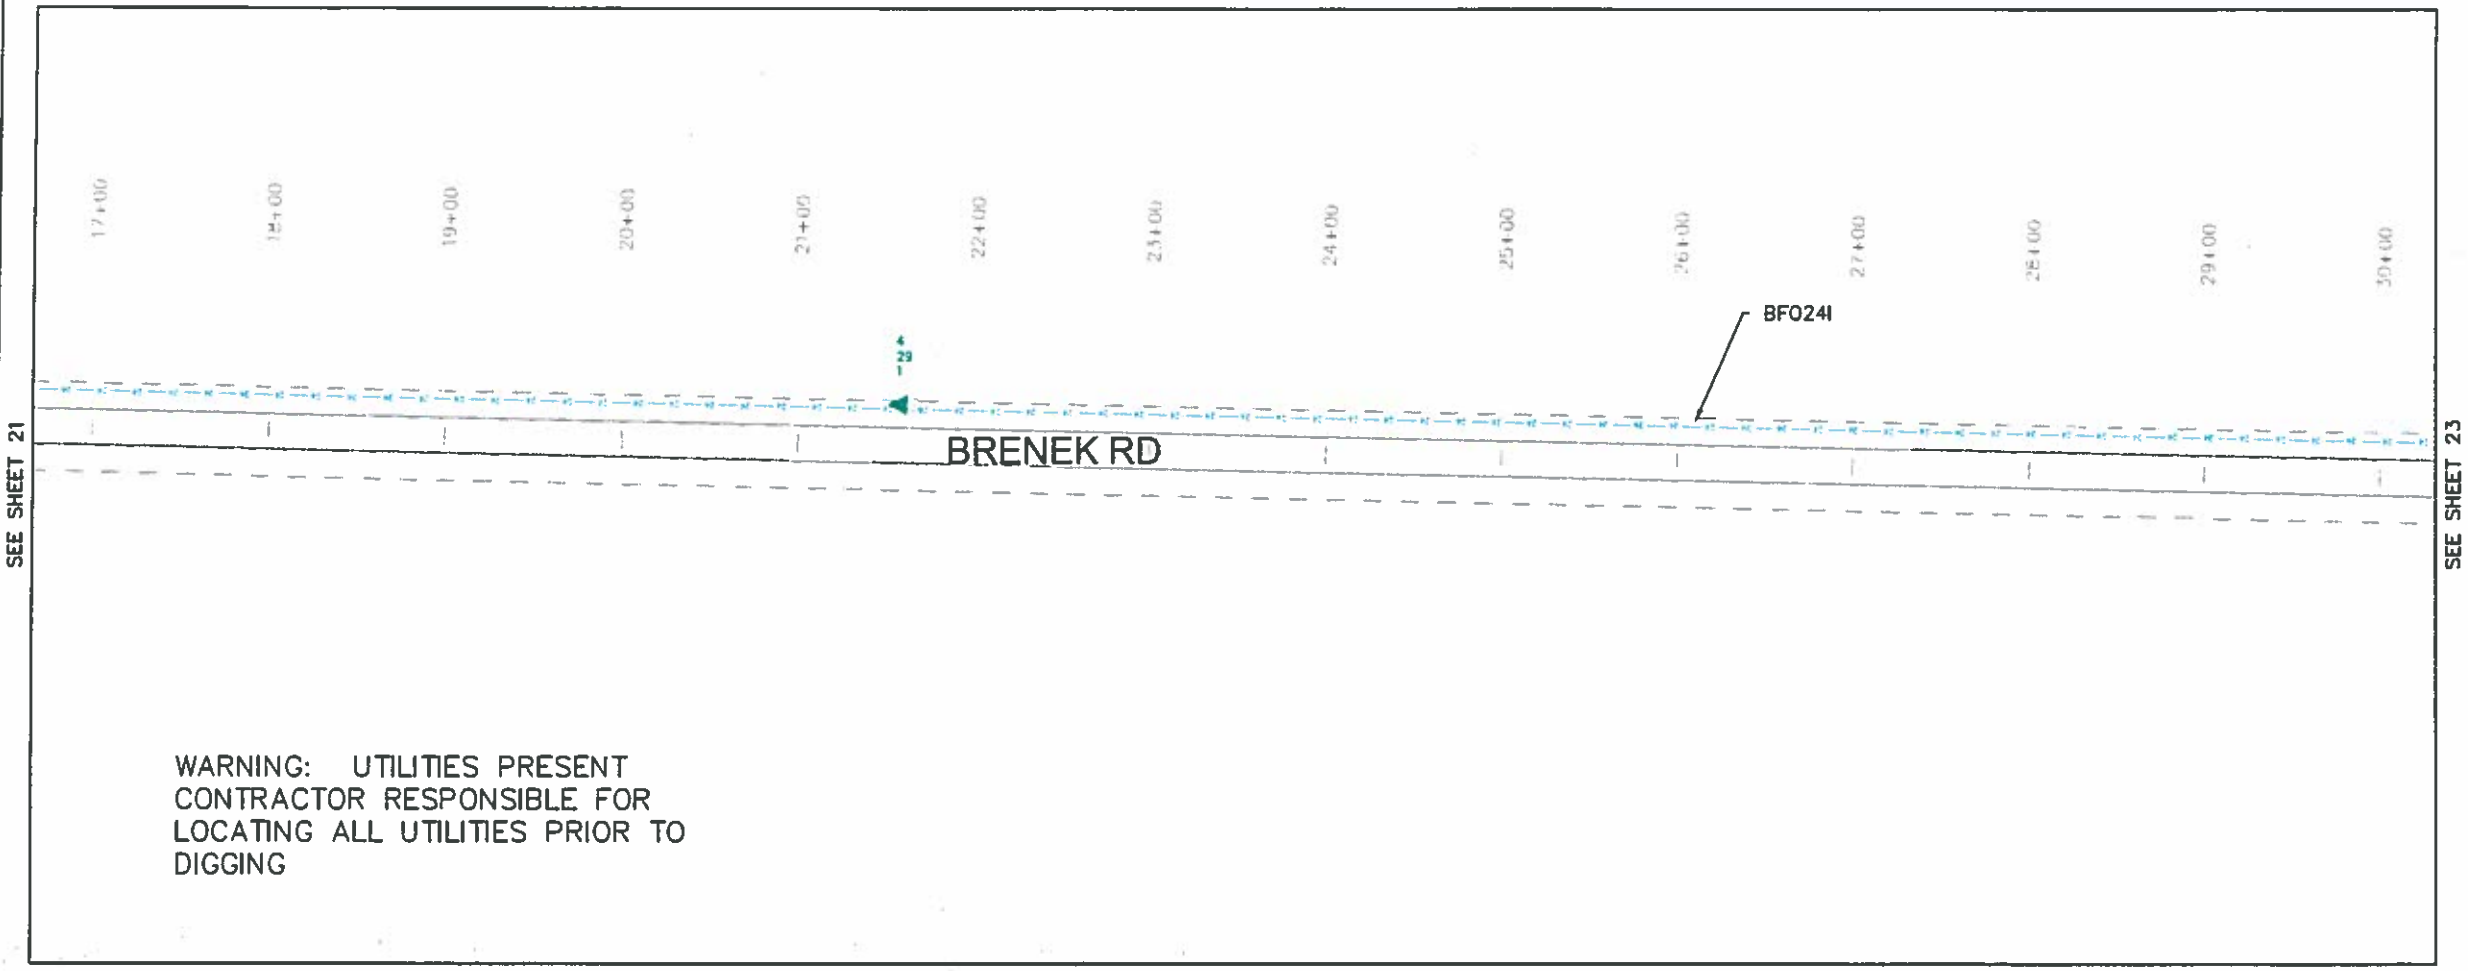

CTTC

EXCH.:	EOLA–VANCOURT
COUNTY:	CONCHO/TOM GREEN
ROUTE:	811–4
SHEET:	2 OF 4
PROJECT:	TX549–02
JOB NO.:	002
CONST. SHT.:	22 OF 24
MAP REF.:	TX549 EOLA 811 SS
TWP:	RGE: SEC:
TAX DIST.:	
AS BUILT DATE:	
TAX CODES	
CITY:	CO:
ESU:	FIRE:
HOSP:	SCH:
SPC:	ST:
DRAWN BY: JMA	
REVIEWED BY:	

ROUTE	HH NO
811	(4)

MISC. NOTES

N-com

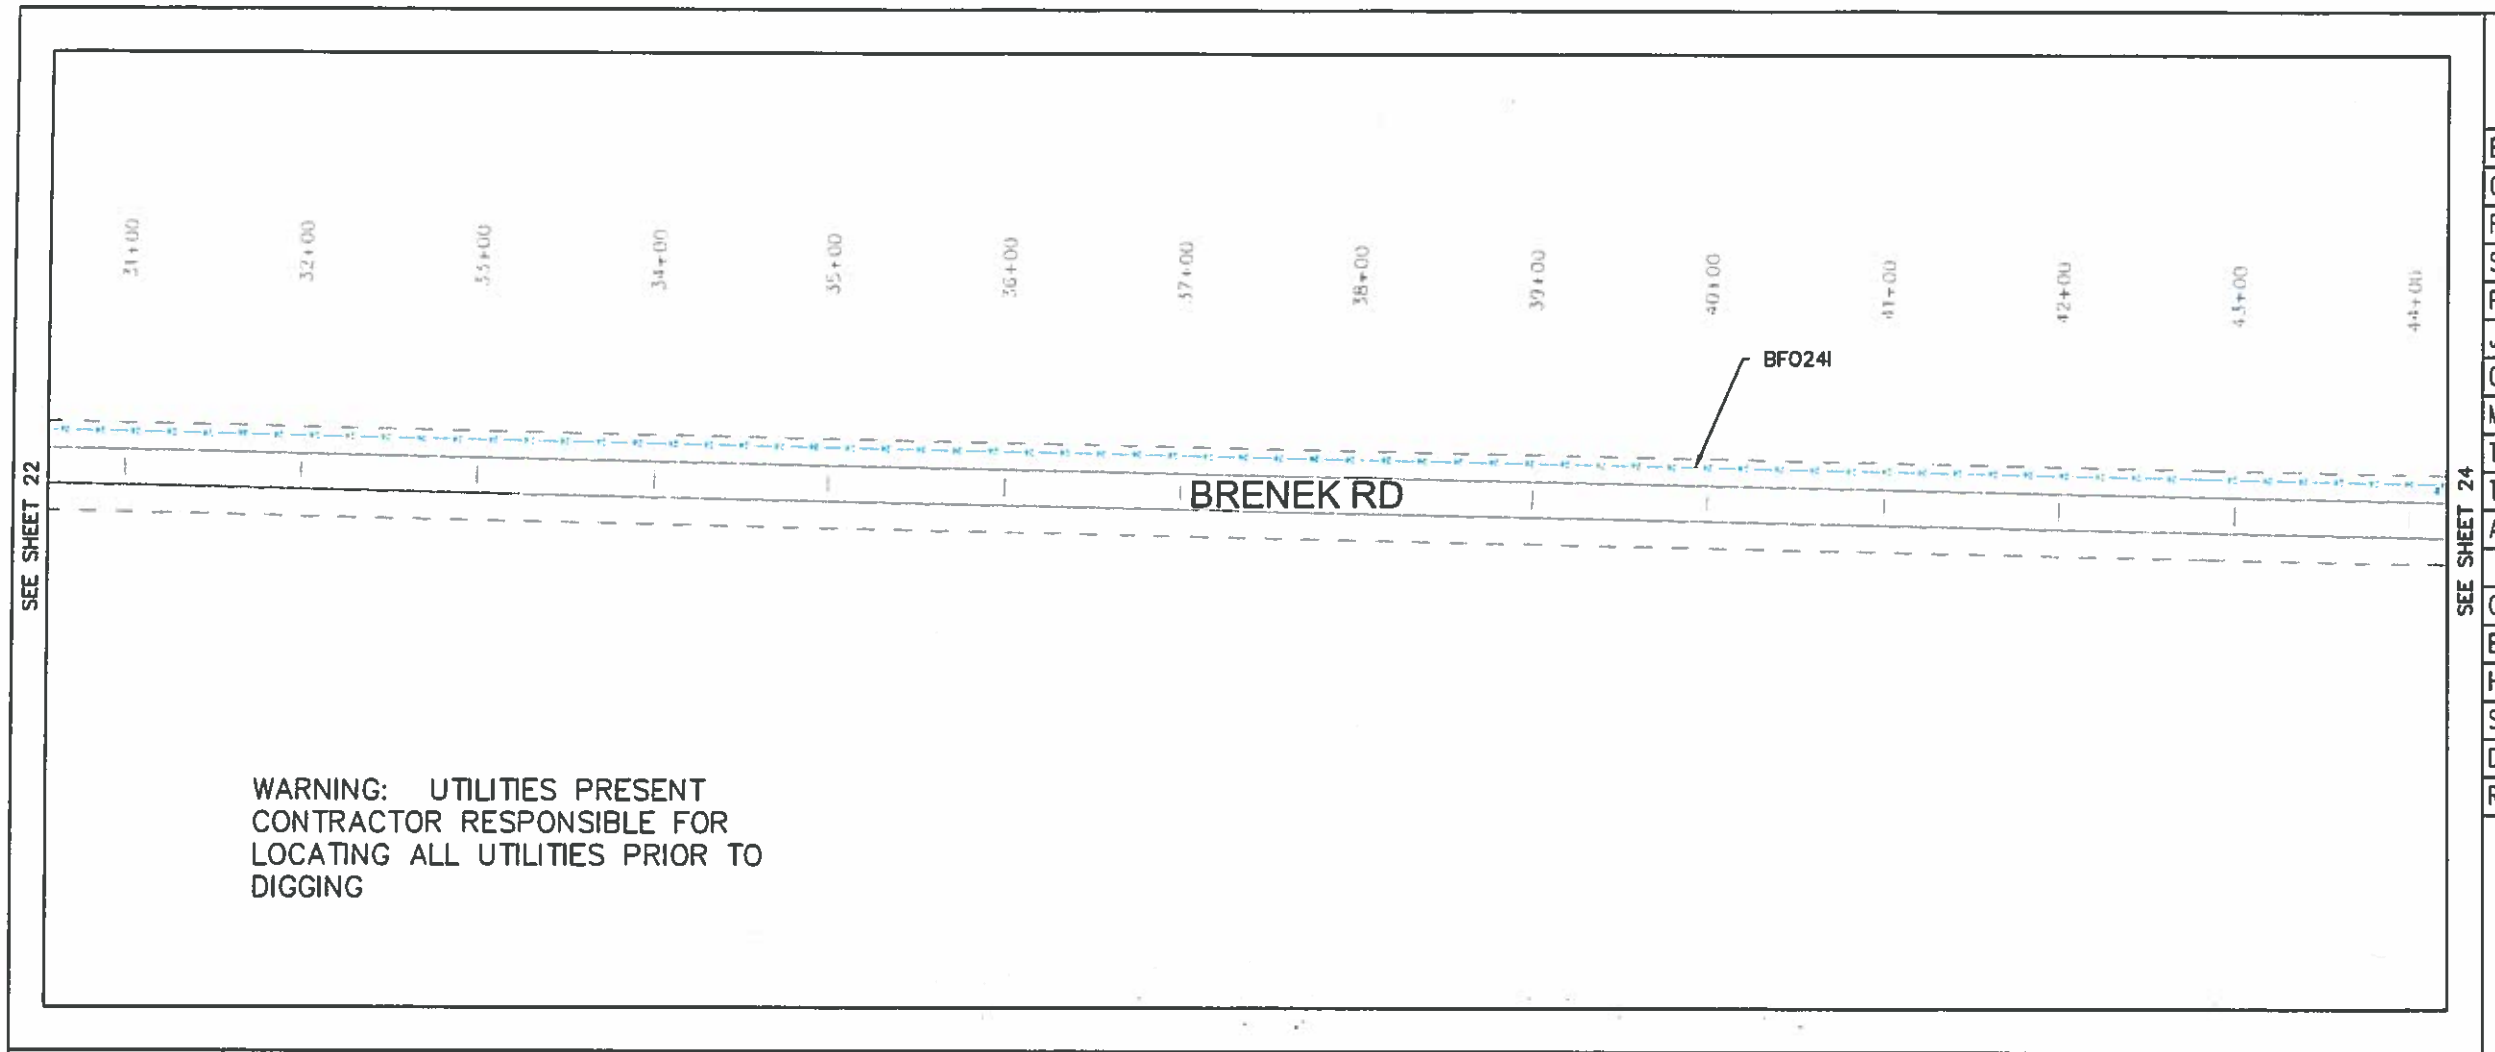

CTTC

EXCH.:	EOLA–VANCOURT
COUNTY:	CONCHO/TOM GREEN
ROUTE:	811–4
SHEET:	3 OF 4
PROJECT:	TX549–02
JOB NO.:	002
CONST. SHT.:	23 OF 24
MAP REF.:	TX549 EOLA 811 SS
TWP:	RGE: SEC:
TAX DIST.:	
AS BUILT DATE:	
TAX CODES	
CITY:	CO:
ESU:	FIRE:
HOSP:	SCH:
SPC:	ST:
DRAWN BY: JMA	
REVIEWED BY:	

ROUTE	HH NO
811	(4)

MISC. NOTES

N-com

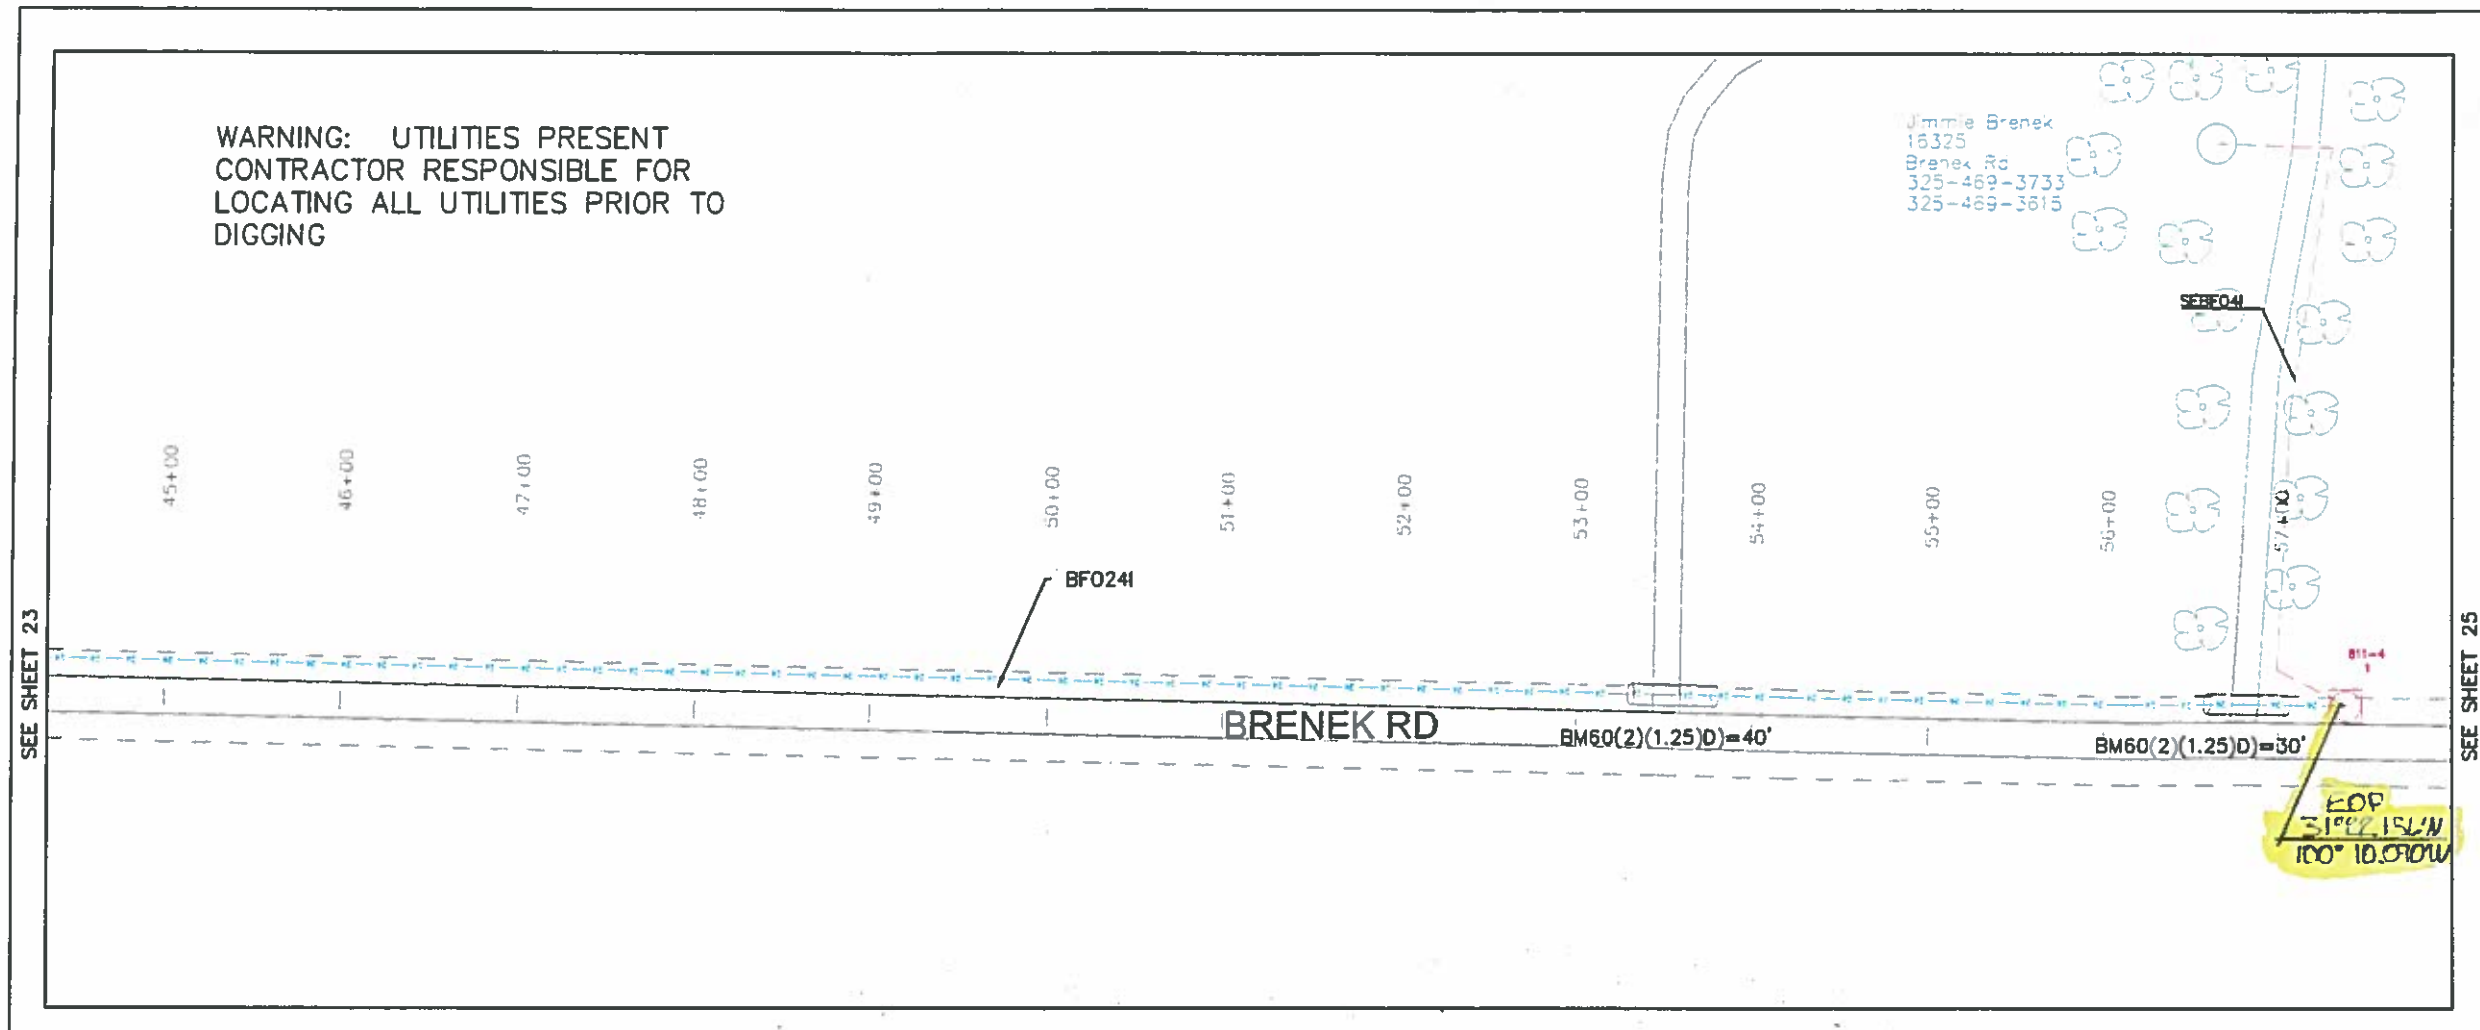

CTTC

EXCH.:	EOLA-VANCOURT
COUNTY:	CONCHO/TOM GREEN
ROUTE:	811-4
SHEET:	4 OF 4
PROJECT:	TX549-02
JOB NO.:	002
CONST. SHT.:	24 OF 24
MAP REF.:	TX549 EOLA 811 SS
TWP:	RGE: SEC:
TAX DIST.:	
AS BUILT DATE:	
TAX CODES	
CITY:	CO:
ESU:	FIRE:
HOSP:	SCH:
SPC:	ST:
DRAWN BY:	JMA
REVIEWED BY:	

ROUTE	HH NO		BHF (30x48 x36)T		BFO 24I					BM BHF 02	BMPD (2X1.25)	BM 53 F	BM 53 AF	BM 52 P	BM 55 B	BM 57 F		BM 83			BM60 (2) (1.25) D				HBFX(S)	HO 1	NID 3G	SEBPD (1.25)			SEB FO 4I	MISC. NOTES
811-4	1		1		5720					1	5600	6	1	1	1	1		1			50				1	2	1	310			60	
					60																40										310	
																					30										10	
			1		5780					1	5600	6	1	1	1	1		1			120				1	2	1	310			380	

N-com