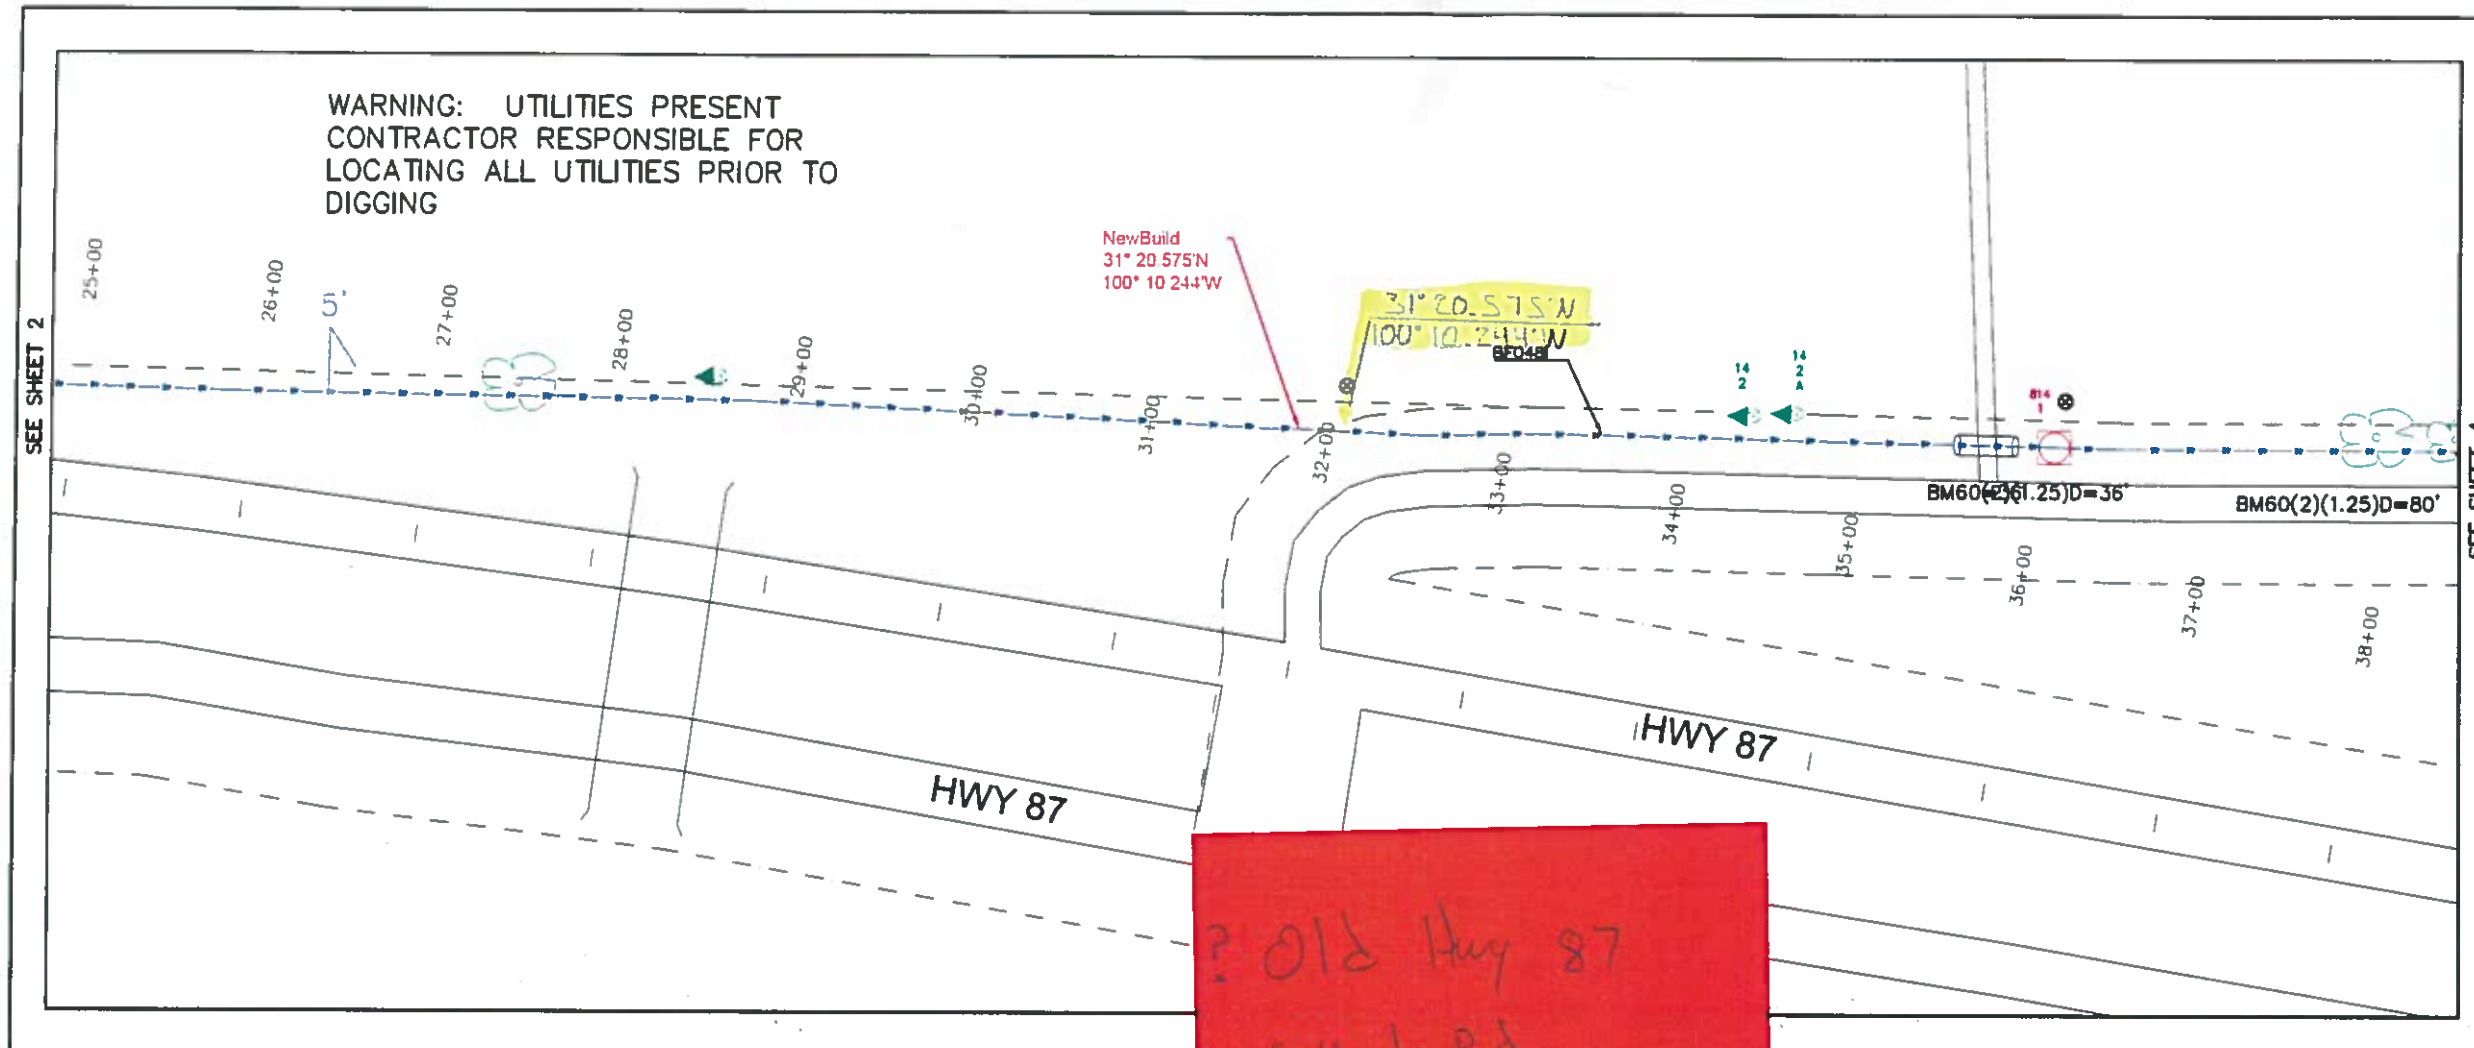

ROUTE	HH NO		BHF (30x48 x36)T		BFO 48I						BMP (2)(1.2										60 2) 25)										
814	1		1		3656						3620										6										
					120																										
			1		3776						3620	3	1	1			1				36										

CTTC

EXCH.:	EOLA–VANCOURT
COUNTY:	CONCHO/TOM GREEN
ROUTE:	814
SHEET:	3 OF 6
PROJECT:	TX549–02
JOB NO.:	002
CONST. SHT.:	3 OF 6
MAP REF.:	TX549 EOLA2 814 SS
TWP:	RGE: SEC:
TAX DIST.:	
AS BUILT DATE:	
TAX CODES	
CITY:	CO:
ESU:	FIRE:
HOSP:	SCH:
SPC:	ST:
DRAWN BY:	JMA
REVIEWED BY:	

MISC. NOTES

N-com

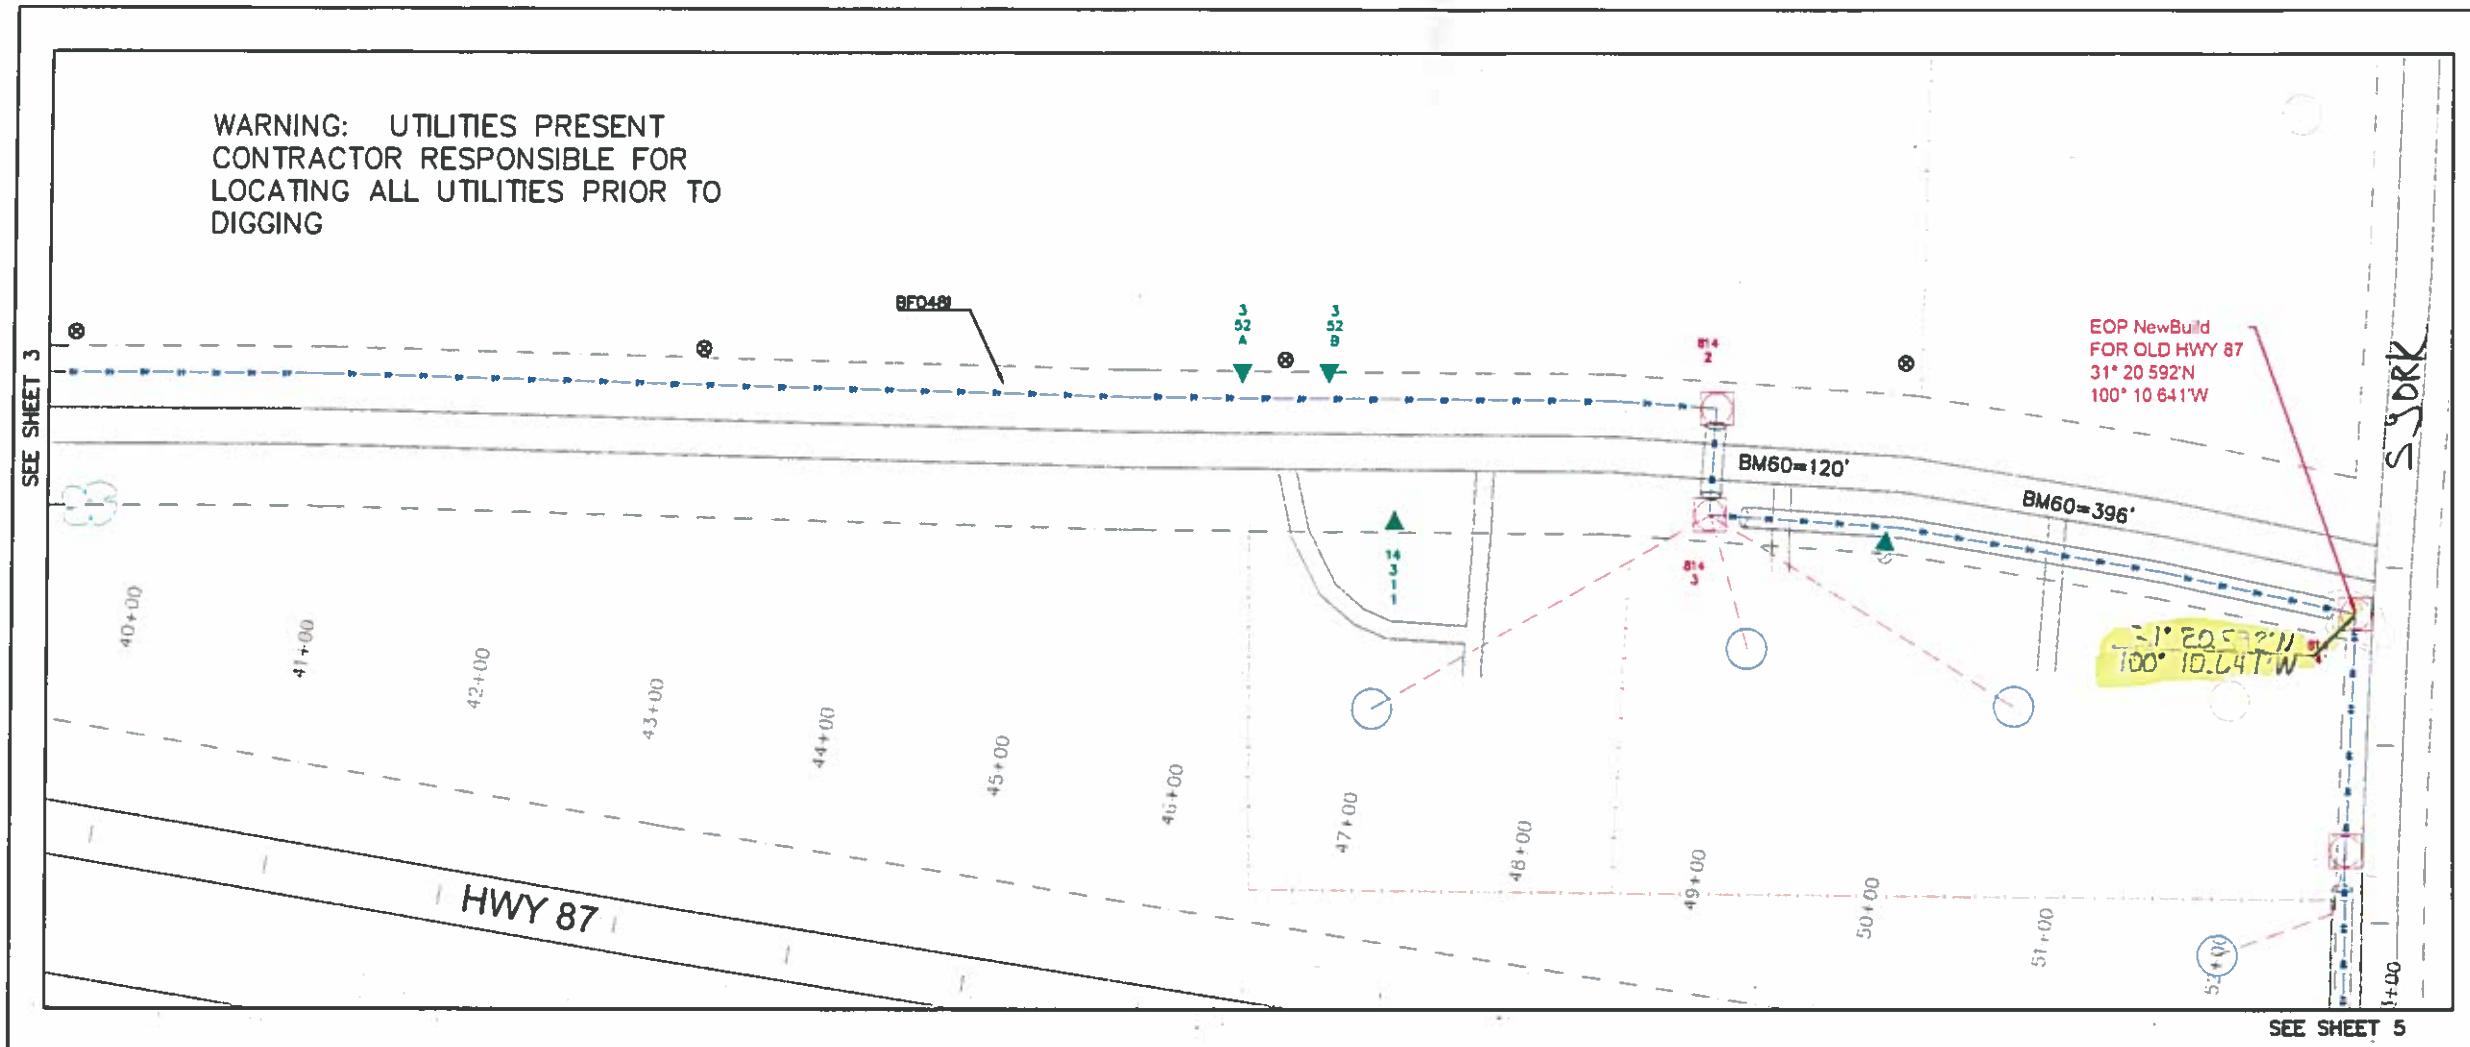

CTTC

EXCH.:	EOLA–VANCOURT
COUNTY:	CONCHO/TOM GREEN
ROUTE:	814
SHEET:	4 OF 6
PROJECT:	TX549–02
JOB NO.:	002
CONST. SHT.:	4 OF 6
MAP REF.:	TX549 EOLA2 814 SS
TWP:	RGE: SEC:
TAX DIST.:	
AS BUILT DATE:	
TAX CODES	
CITY:	CO:
ESU:	FIRE:
HOSP:	SCH:
SPC:	ST:
DRAWN BY: JMA	
REVIEWED BY:	

ROUTE	HH NO		BHF (30x48 x36)T		BFO 48I					BM BHF 02	BMPD (2)(1.25)		BM 53 AF	BM 52 P	BM 55 B	BM 57 F	BM 57 NS	BM 83			BM60 (2) (1.25) D		BM AGW	NBFO (M)	HO 1	NID 3G	NID 4G	SEBPD (1.25)			SEB FO 4I	MISC. NOTES
814	2		1		1238						1158		1	1			1				80											
					120																											
814	3		1		120					1			1	1	1	1		1			120		40	1	2		1	150			150	
					120																										60	
																															10	
																		1					30		2		1	150			150	
																															60	
																															10	
																		1							2	1		240			240	
																															60	
																															10	
814	4		1		396					1			1	1			1				396											
					120																											
			3		2114					2	1158		3	3	1	1	2	3			596		70	1	6	1	2	540			750	

N-com

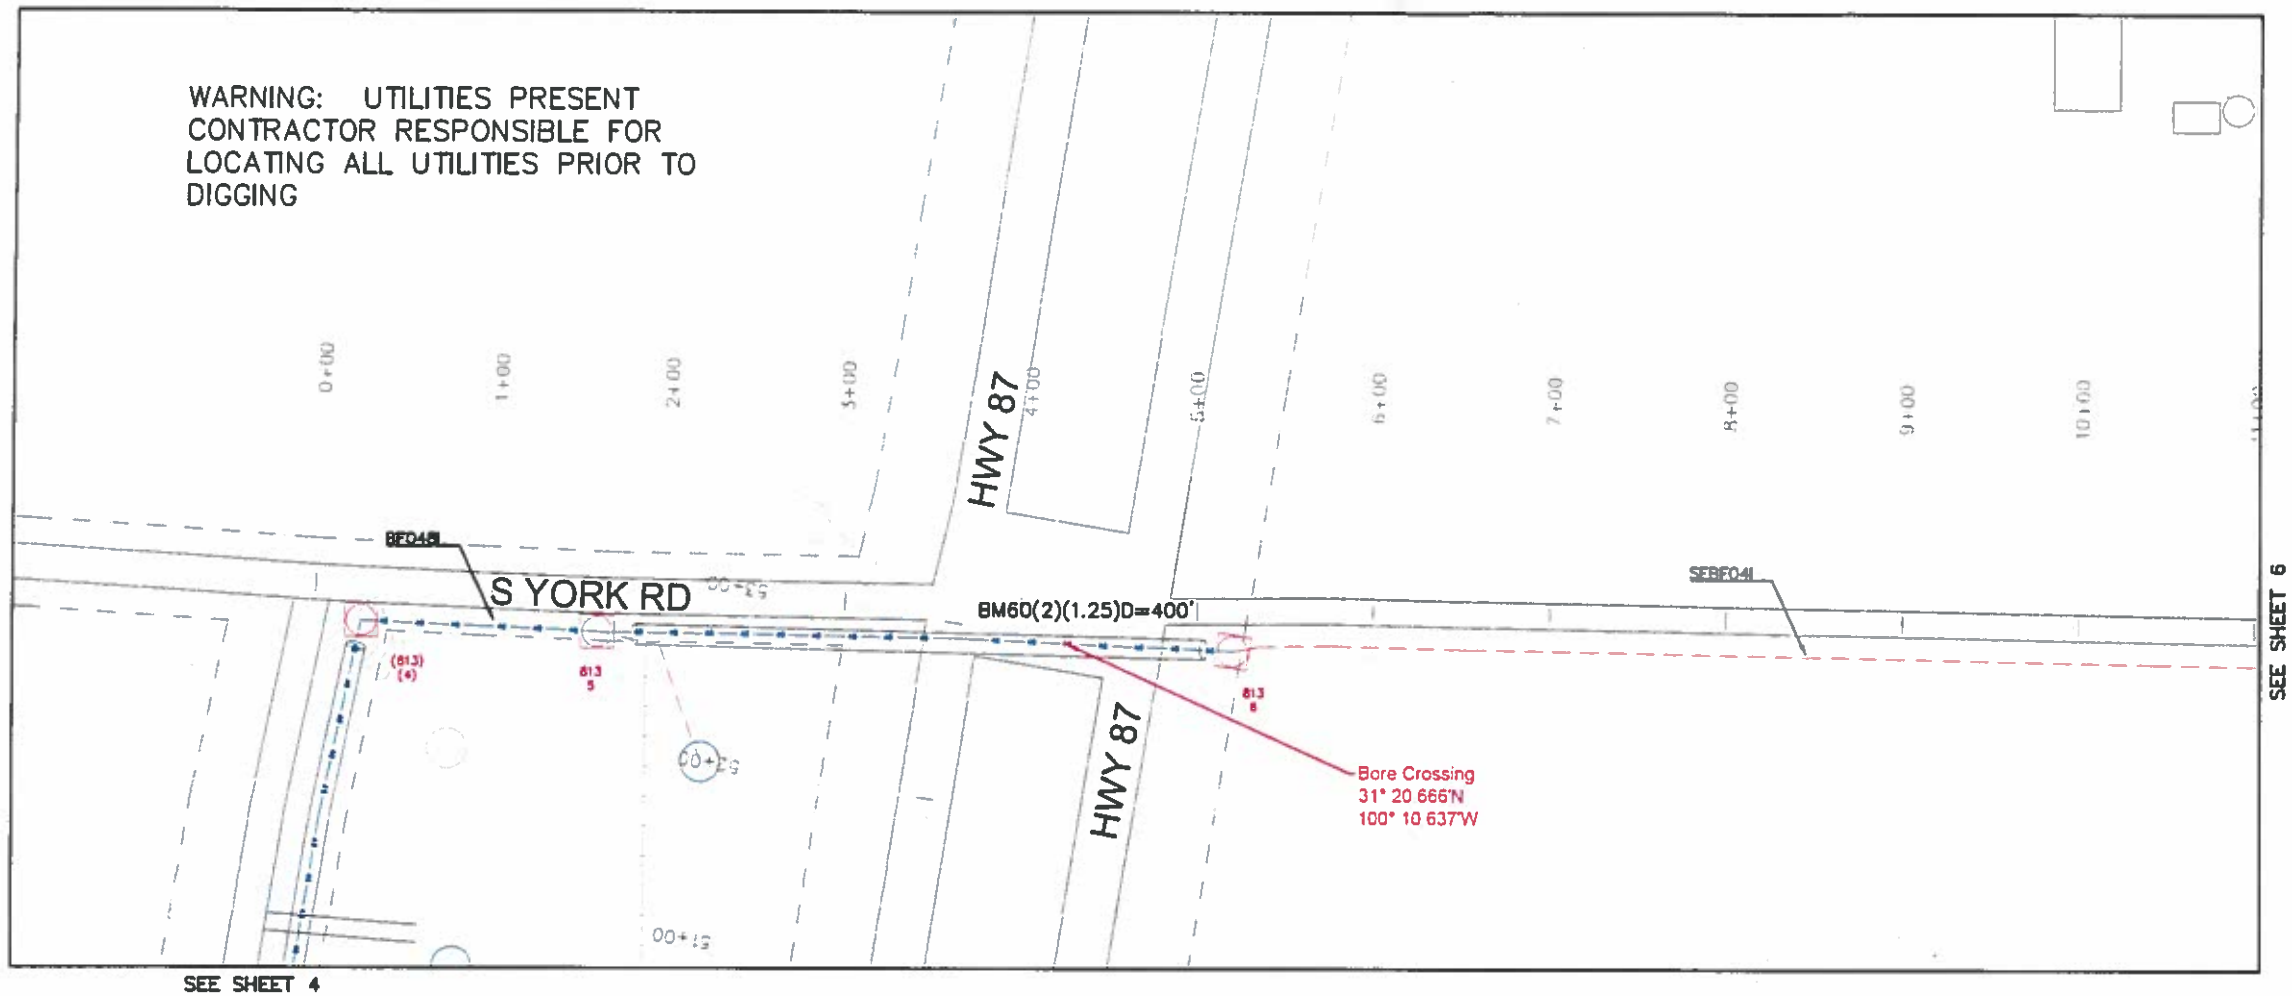

CTTC

EXCH.:	EOLA-VANCOURT
COUNTY:	CONCHO/TOM GREEN
ROUTE:	814
SHEET:	5 OF 6
PROJECT:	TX549-02
JOB NO.:	002
CONST. SHT.:	5 OF 6
MAP REF.:	TX549 EOLA2 814 SS
TWP:	RGE: SEC:
TAX DIST.:	
AS BUILT DATE:	
TAX CODES	
CITY:	CO:
ESU:	FIRE:
HOSP:	SCH:
SPC:	ST:
DRAWN BY:	JMA
REVIEWED BY:	

ROUTE	HH NO		BHF (30x48 x36)T		BFO 48I					BM BHF 02	BMPO (2)(1.25)		BM 53 AF	BM 52 P	BM 55 B	BM 57 F	BM 57 NS	BM 83			BM60 (1) (1.25) D			HBFO (M)		HO 1	NID 3G	SEBPO (1.25)			SEB FO 4I	MISC. NOTES
814	5		1		154					1	154		1	1	1	1		1						1		2	1	130			130	
					120																										60	
																															10	
814	6		1		424					1	24		1	1			1				400			1		2					60	
					60																											
			2		758					2	178		2	2	1	1	1	1			400			2		4	1	130			260	

N-com

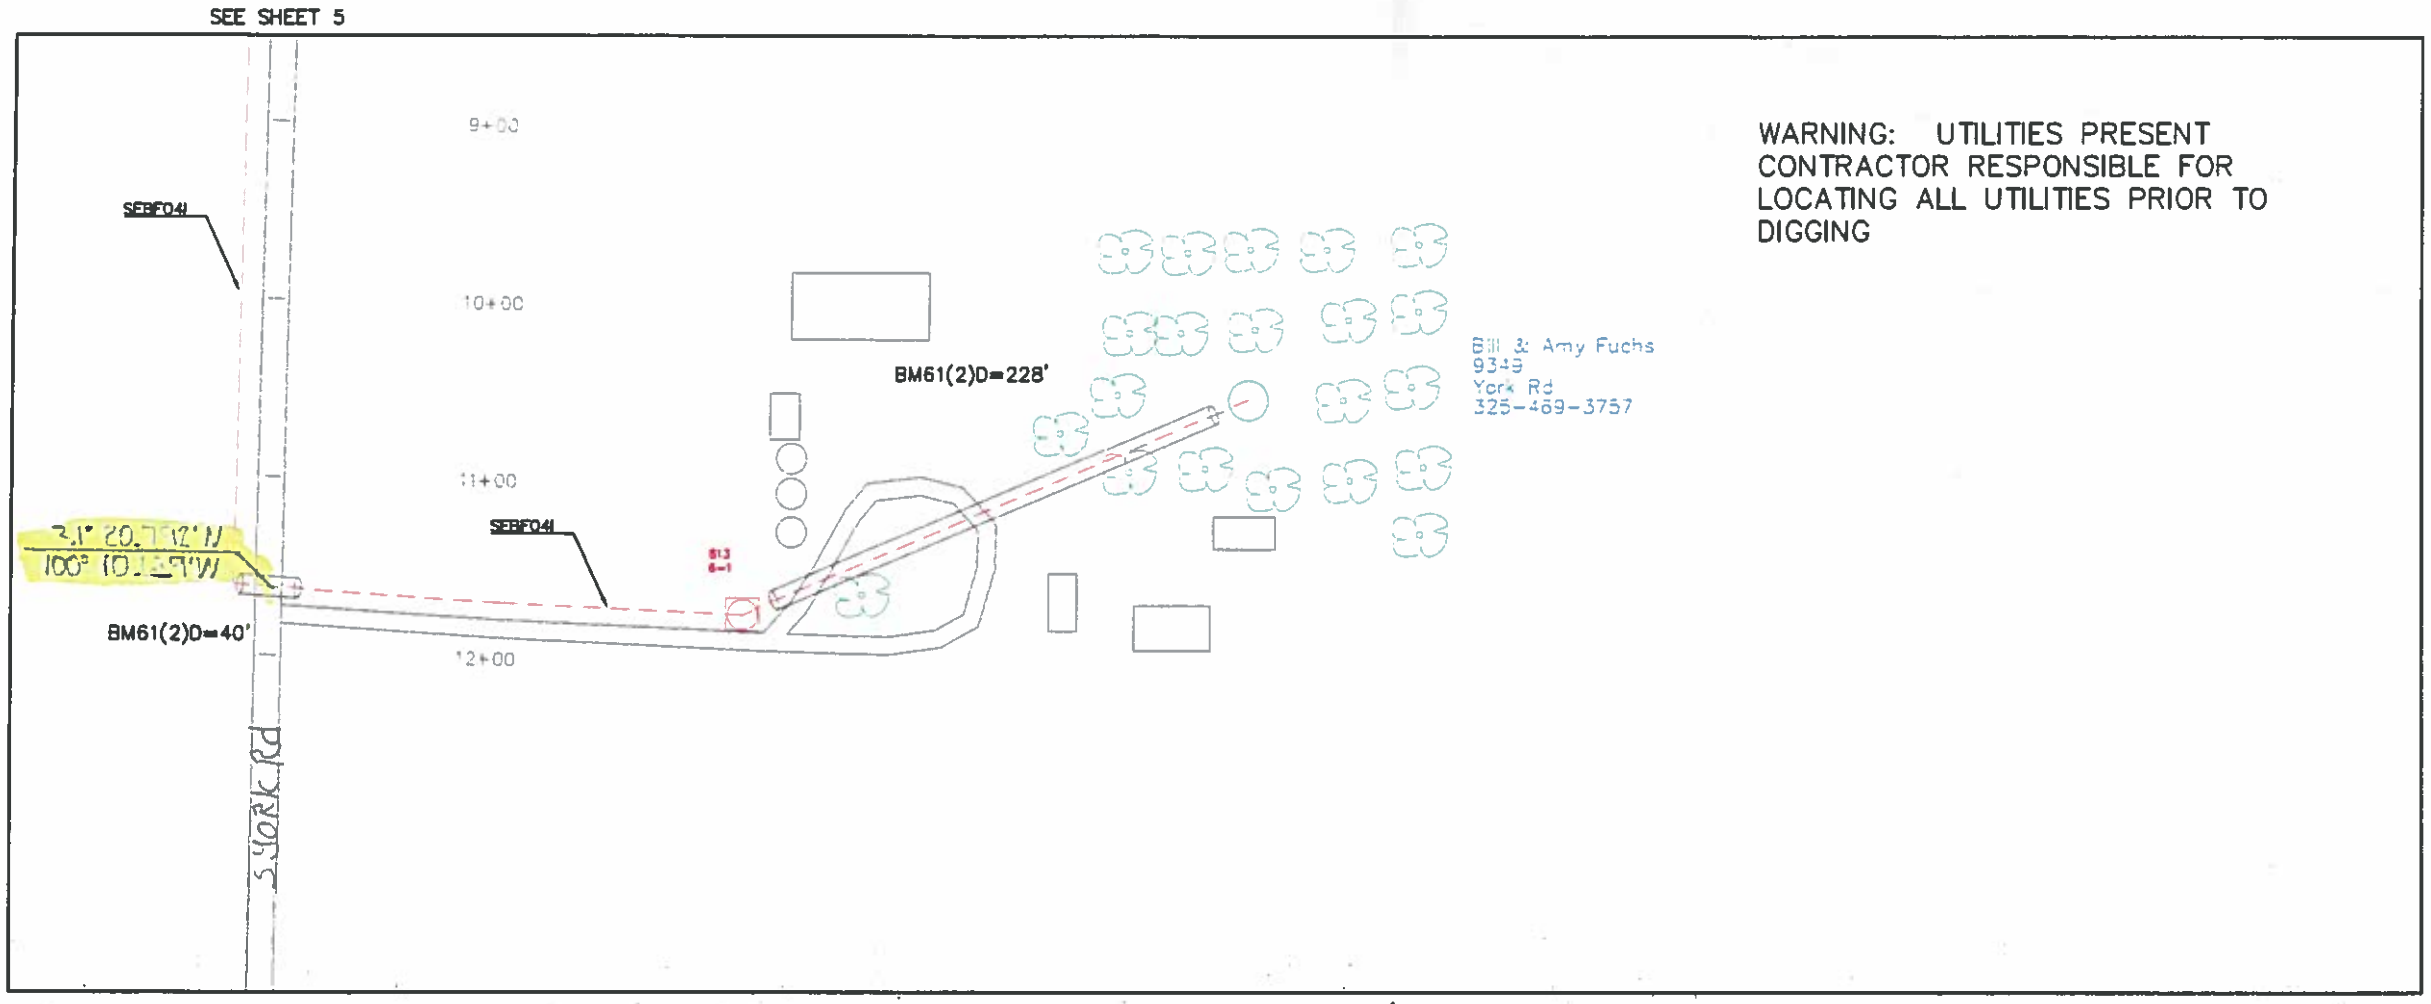

WARNING: UTILITIES PRESENT
CONTRACTOR RESPONSIBLE FOR
LOCATING ALL UTILITIES PRIOR TO
DIGGING

CTTC

EXCH.:	EOLA-VANCOURT
COUNTY:	CONCHO/TOM GREEN
ROUTE:	814
SHEET:	6 OF 6
PROJECT:	TX549-02
JOB NO.:	002
CONST. SHT.:	6 OF 6
MAP REF.:	TX549 EOLA2 814 SS
TWP:	RGE: SEC:
TAX DIST.:	
AS BUILT DATE:	
TAX CODES	
CITY:	CO:
ESU:	FIRE:
HOSP:	SCH:
SPC:	ST:
DRAWN BY: JMA	
REVIEWED BY:	

ROUTE	HH NO		BHF (30x48 x36)T		BFO 41					BM BHF 02	BMPD (1) (1.25)		BM 53 AF	BM 52 P		BM 57 NS		BM 83			BM61 (2)D		BM AGW					NID 4G			SEB FO 41	MISC. NOTES
814	6-1		1		1078					1	1078		1	1		1		1			40		60					1			228	
					60						228										228										10	
																															60	
			1		1138					1	1306		1	1		1		1			268		60					1			298	

N-com