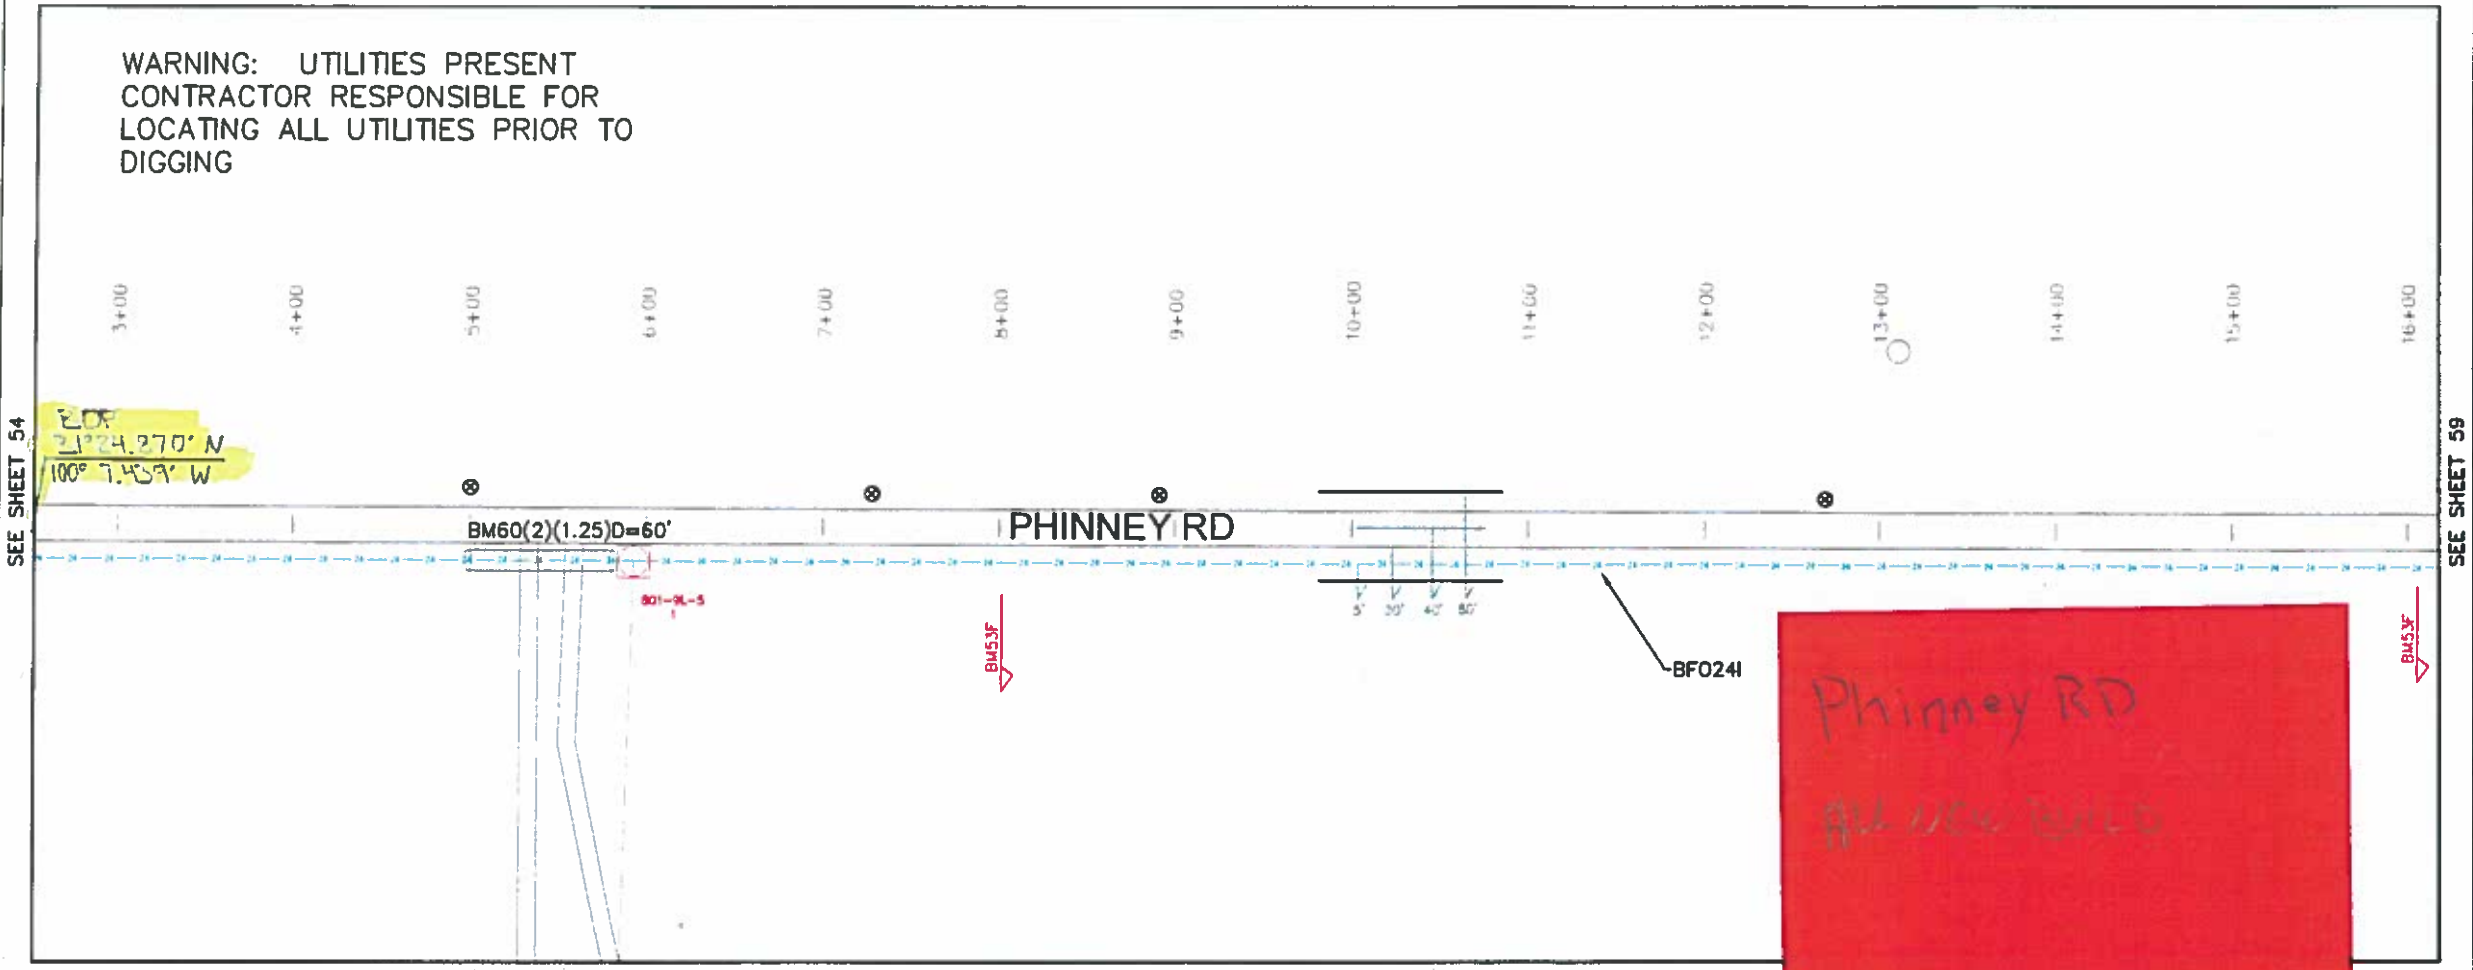

Phinney RD

ALL NEW BURIED

CTTC

EXCH.:	EOLA
COUNTY:	CONCHO/TOM GREEN
ROUTE:	801-9L-5
SHEET:	1 OF 9
PROJECT:	TX549-02
JOB NO.:	002
CONST. SHT.:	58 OF 117
MAP REF.:	TX549 EOLA 801 SS
TWP:	RGE: SEC:
TAX DIST.:	
AS BUILT DATE:	
TAX CODES	
CITY:	CO:
ESU:	FIRE:
HOSP:	SCH:
SPC:	ST:
DRAWN BY: JMA	
REVIEWED BY:	

ROUTE	HH NO		BHF (30x48 x36)T		BFO 241						BMPD (2)(1.25)	BM BHF 02	BM 53 AF	BM 52 P	BM 55 B	BM 57 F	BM 83				BM60 (2)(1.25)D									SEB FO 41	MISC. NOTES
801-9L-5	1		1		600						540	1	1	1	1	1	1				60									60	
					120																									450	
																														10	
			1		720						540	1	1	1	1	1	1				60			1		2			1	450	520	

N-com

WARNING: UTILITIES PRESENT
CONTRACTOR RESPONSIBLE FOR
LOCATING ALL UTILITIES PRIOR TO
DIGGING

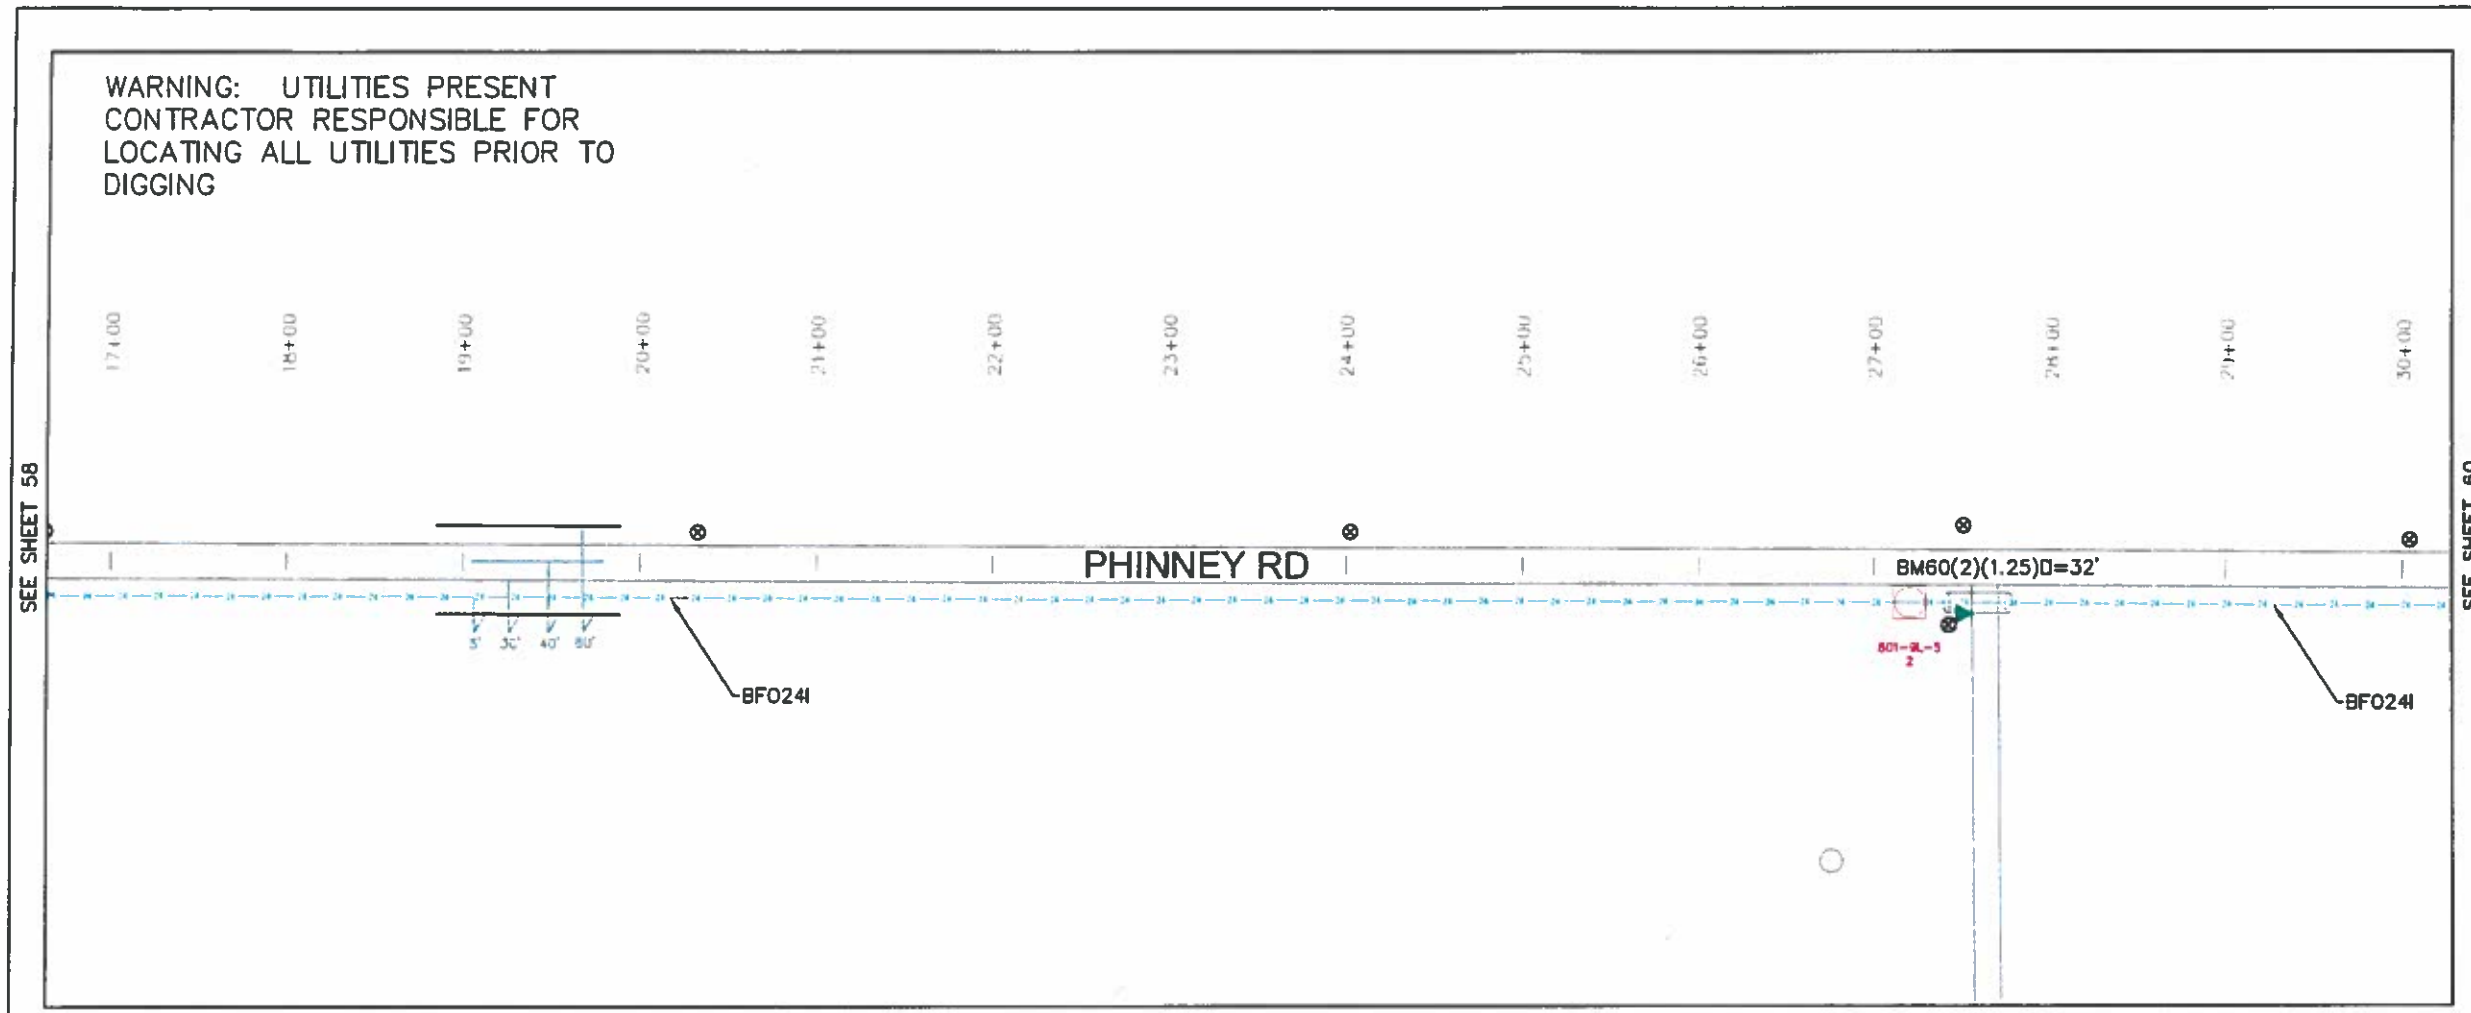

CTTC

EXCH.:	EOLA
COUNTY:	CONCHO/TOM GREEN
ROUTE:	801-9L-5
SHEET:	2 OF 9
PROJECT:	TX549-02
JOB NO.:	002
CONST. SHT.:	59 OF 117
MAP REF.:	TX549 EOLA 801 SS
TWP:	RGE: SEC:
TAX DIST.:	
AS BUILT DATE:	
TAX CODES	
CITY:	CO:
ESU:	FIRE:
HOSP:	SCH:
SPC:	ST:
DRAWN BY: JMA	
REVIEWED BY:	

ROUTE	HH NO		BHF (30x48 x36)T		BFO 241						BMPD (2)(1.25)	WBM 53 F	BM 53 AF	BM 52 P			BM 53 F	BM 57 NS													
801-9L-5	2		1		2030						2030	1	1	1			1	1													
					120																										
			1		2150						2030	1	1	1			1	1													

MISC. NOTES

N-com

WARNING: UTILITIES PRESENT
CONTRACTOR RESPONSIBLE FOR
LOCATING ALL UTILITIES PRIOR TO
DIGGING

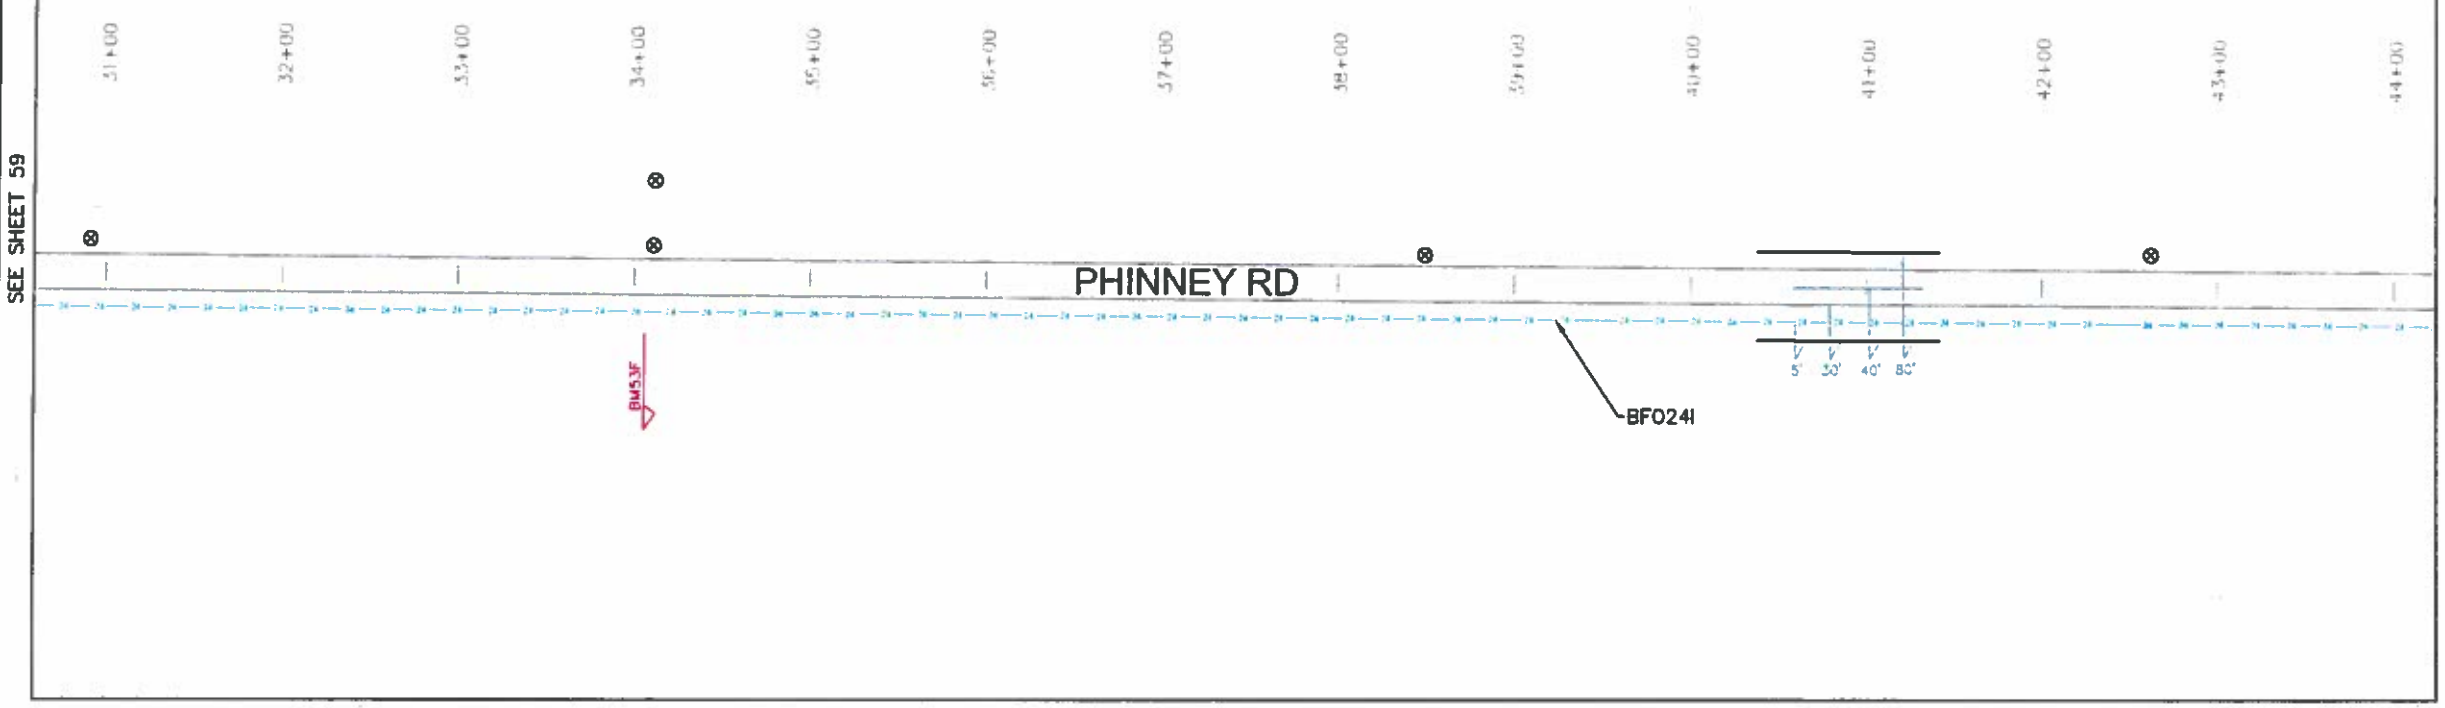

CTTC

EXCH.:	EOLA
COUNTY:	CONCHO/TOM GREEN
ROUTE:	801-9L-5
SHEET:	3 OF 9
PROJECT:	TX549-02
JOB NO.:	002
CONST. SHT.:	60 OF 117
MAP REF.:	TX549 EOLA 801 SS
TWP:	RGE: SEC:
TAX DIST.:	
AS BUILT DATE:	
TAX CODES	
CITY:	CO:
ESU:	FIRE:
HOSP:	SCH:
SPC:	ST:
DRAWN BY:	JMA
REVIEWED BY:	

ROUTE	HH NO
801-9L-5	

MISC. NOTES

N-com

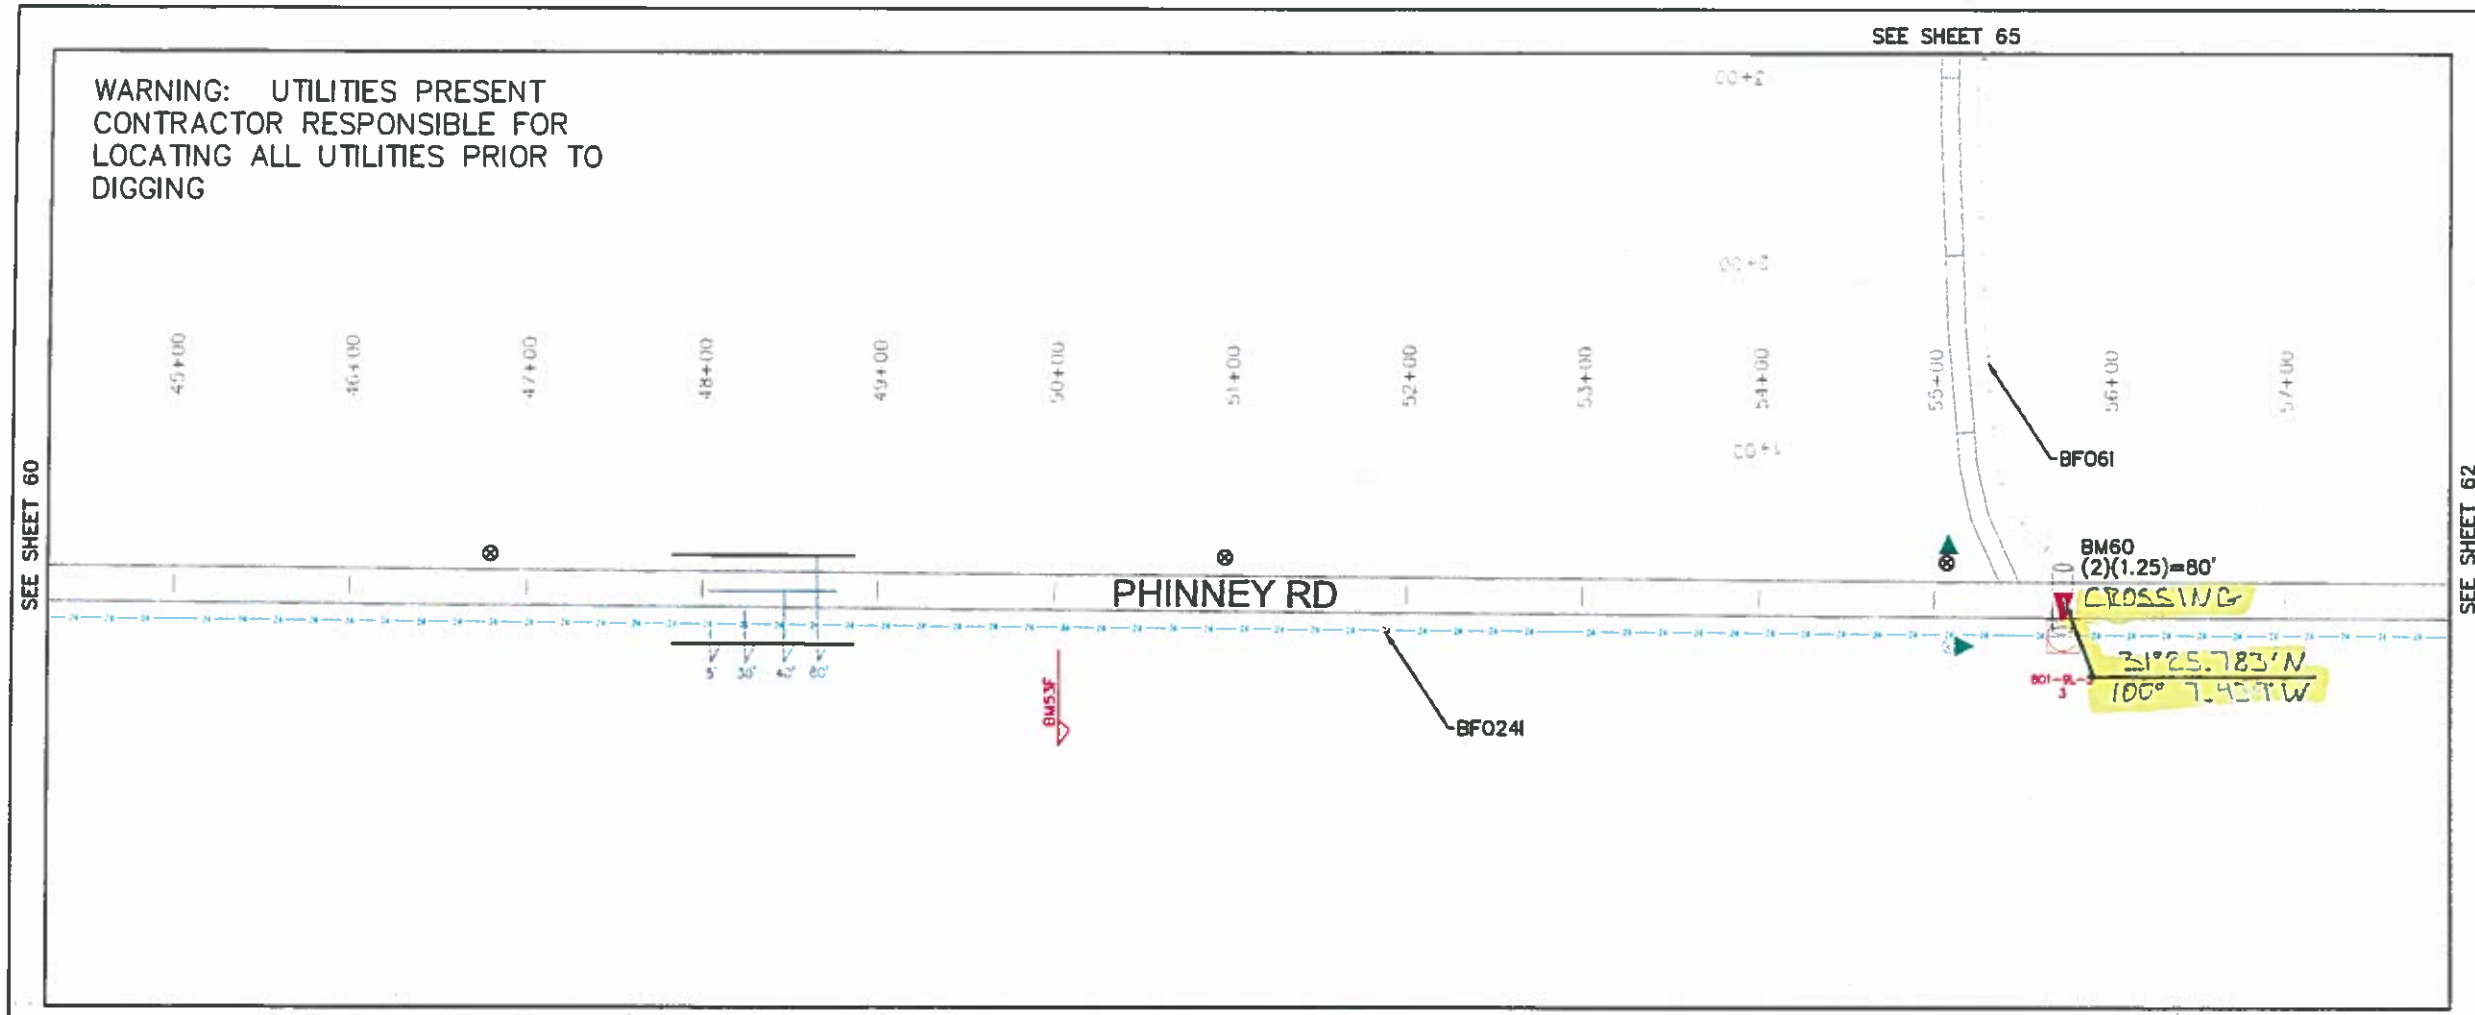

CTTC

EXCH.:	EOLA
COUNTY:	CONCHO/TOM GREEN
ROUTE:	801-9L-5
SHEET:	4 OF 9
PROJECT:	TX549-02
JOB NO.:	002
CONST. SHT.:	61 OF 117
MAP REF.:	TX549 EOLA 801 SS
TWP:	RGE: SEC:
TAX DIST.:	
AS BUILT DATE:	
TAX CODES	
CITY:	CO:
ESU:	FIRE:
HOSP:	SCH:
SPC:	ST:
DRAWN BY: JMA	
REVIEWED BY:	

ROUTE	HH NO		BHF (30x48 x36)T		BFO 24I						BMPD (2)(1.25)	BM BHF 02	BM 53 AF	BM 52 P	BM 55 B	BM 57 F	BM 53 F				BM60 (2)(1.25) D			HBFO (M)		HO 1						MISC. NOTES
801-9L-5	3		1		2828						2796	1	1	1	1	1	3				32			1		2						
					120																											
			1		2948						2796	1	1	1	1	1	3				32			1		2						

N-com

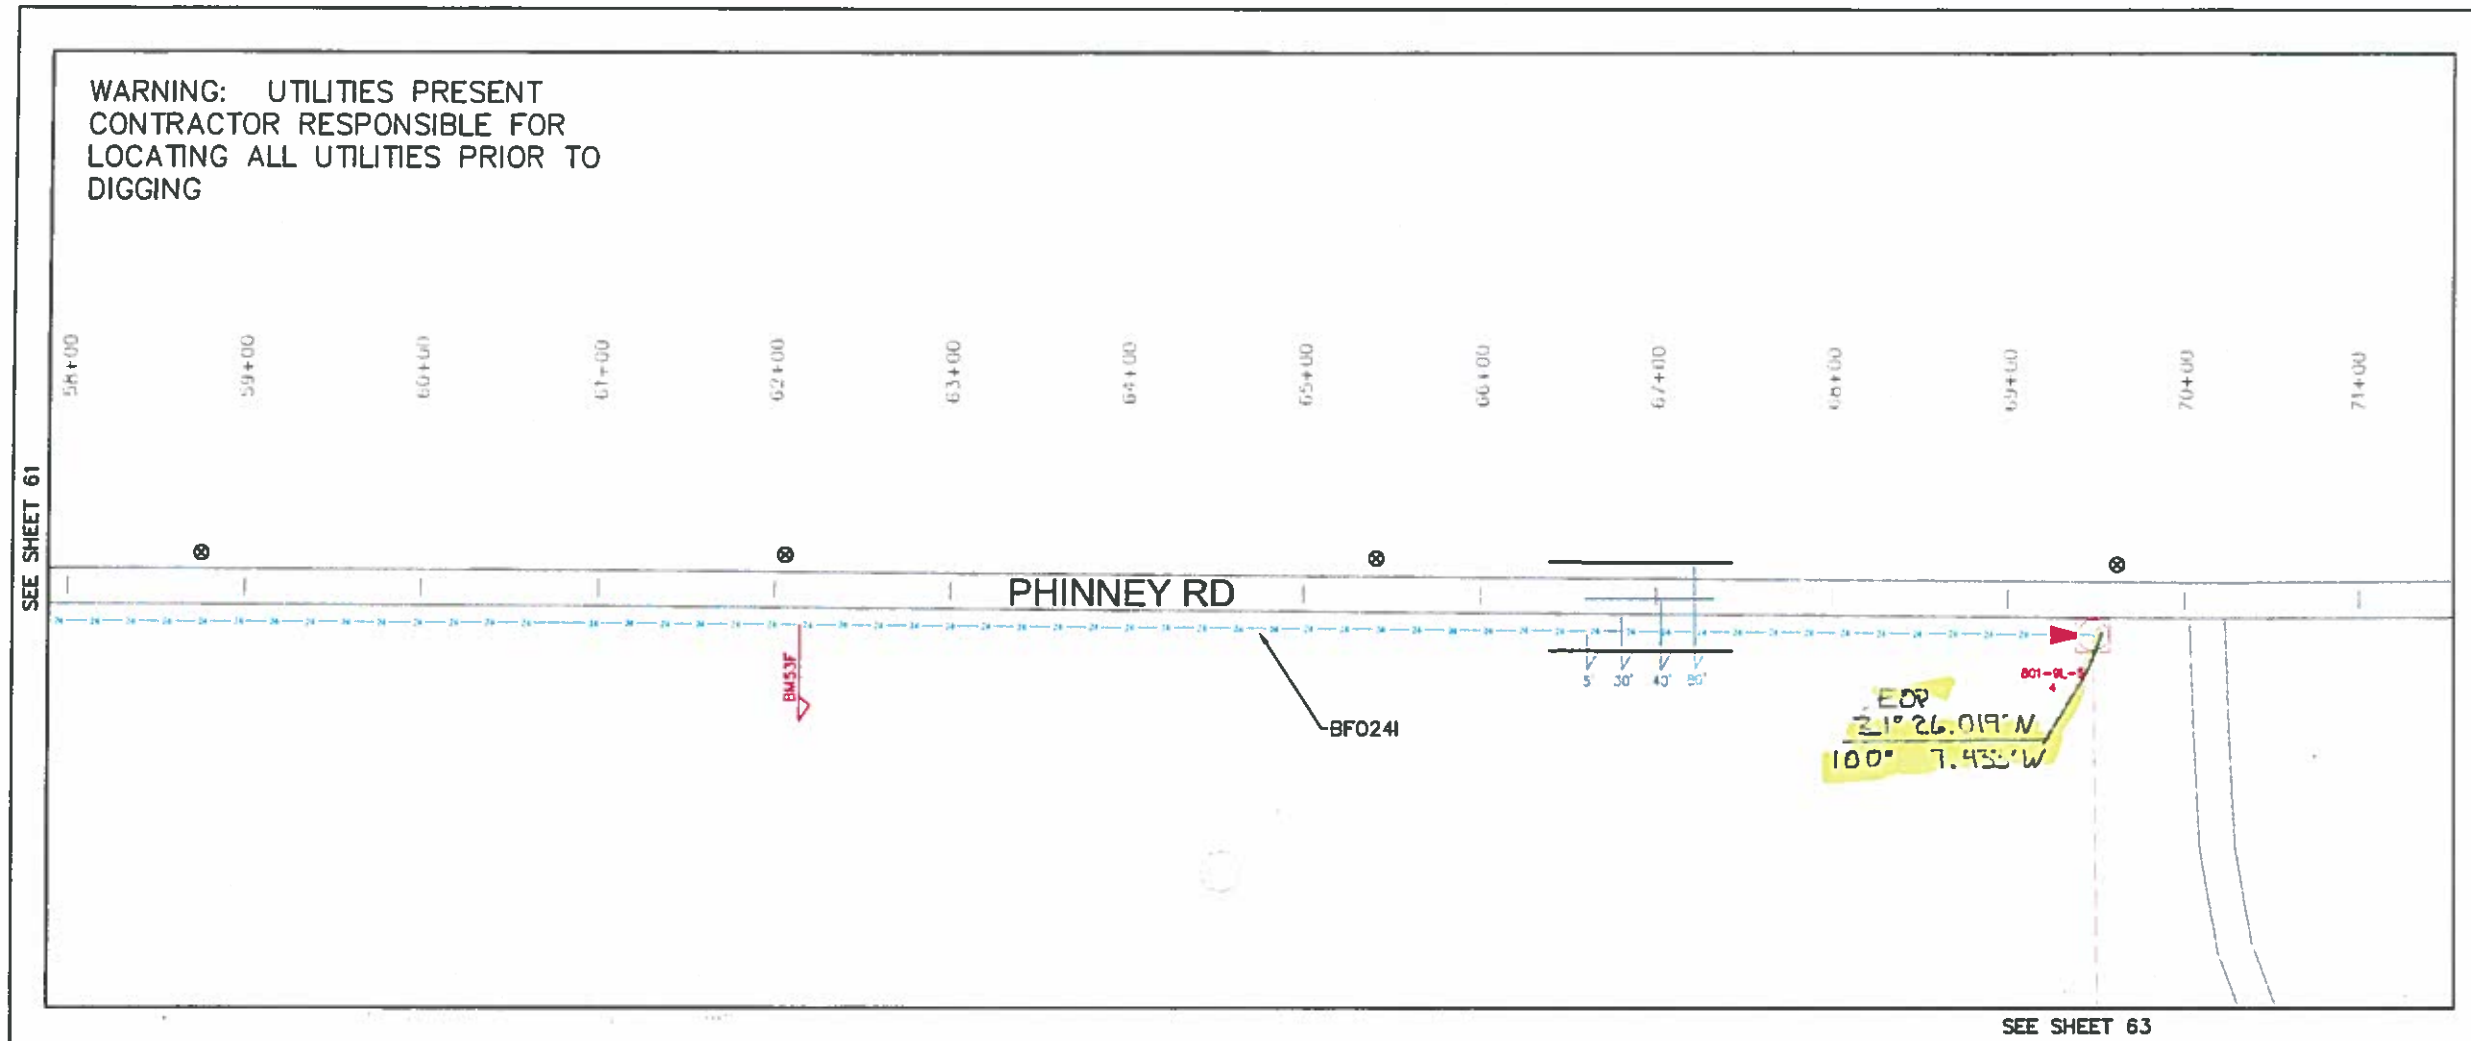

CTTC

EXCH.:	EOLA
COUNTY:	CONCHO/TOM GREEN
ROUTE:	801-9L-5
SHEET:	5 OF 9
PROJECT:	TX549-02
JOB NO.:	002
CONST. SHT.:	62 OF 117
MAP REF.:	TX549 EOLA 801 SS
TWP:	RGE: SEC:
TAX DIST.:	
AS BUILT DATE:	
TAX CODES	
CITY:	CO:
ESU:	FIRE:
HOSP:	SCH:
SPC:	ST:
DRAWN BY: JMA	
REVIEWED BY:	

ROUTE	HH NO		BHF (30x48 x36)T		BFO 241						BMPD (2)(1.25)	BM BHF 02	BM 53 AF	BM 52 P	BM 55 B	BM 57 F	BM 53 F	BM 83						HBFO (M)		HO 1			NID 3G	SEBPD (1) (1.25)	SEB FO 41	MISC. NOTES
801-9L-5	4		1		1410						1410	1	1	1	1	1	1	1						1		2			1	500	60	
					60																										500	
																															10	
			1		1470						1410		1	1	1	1	1	1						1		2			1	500	570	

N-com